

HANCOCK
K 304
9-12-74

MISSISSIPPI
 BOARD OF WATER COMMISSIONERS
 416 North State Street
 Jackson, Mississippi 39201

CODED

WATER WELL DRILLERS LOG

Sept. 12, 1974 Mc Gill Well Drills Hancock
 date well completed firm name county well located

LANDOWNER:
Marie P. Scott
Box 13A
Bay St. Louis, Miss
 WELL LOCATION:
 sec. 6 T. 9 N. R. 14 E.
3 miles W of Laveland
 (distance) (direction) (nearest town)


WELL PURPOSE: HOME
 (home, irrigation, municipal, industrial)

WELL COMPLETION DATA:
 (1) diameter (inches) 2"
 (2) total depth (feet) 589
 (3) static water level (feet) 2' below top of ground.
 (4) casing P.V.C. 579
 (material) (depth)
 (size) If telescope see back.
 (5) screen 10' 579
 (length) (depth to top)
2" S.S.
 (size) (material)
 (6) pump 1 15
 (HP) (yield gpm)
electric
 (type power)
 (7) electric log no
 (yes or no)
 (organization running log)

description of formations encountered	from	to
Clay	0	18
fine sand	18	41
blue clay	41	82
fine sand	82	124
slush	124	161
fine sand	161	189
slush	189	206
blue clay	206	242
fine sand	242	292
slush	292	298
fine sand	298	318
blue clay	318	355
fine sand	355	378
blue clay	378	417
slush	417	461
blue clay	461	502
fine sand	502	555
Coarse sand	555	589

(8) how well bottom plugged sand shack
back wash water


DRILLERS REMARKS:

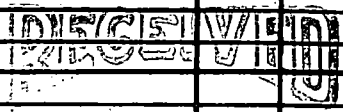

JAN 21 1975

If well telescopes please sketch and show depths.

GROUND LEVEL

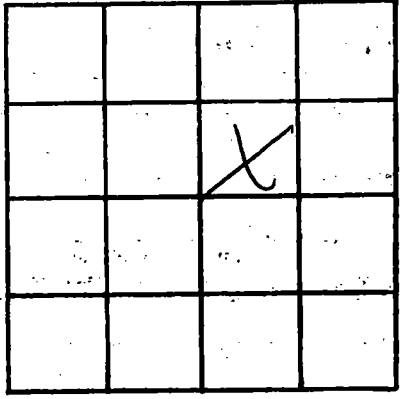

SECTION 6

Please indicate well location X.

ADDITIONAL INFORMATION

Lined area for additional information.

If more than one screen, show locations of each on sketch.