

HANCOCK
K 311
4-5-75

MISSISSIPPI
 BOARD OF WATER COMMISSIONERS
 416 North State Street
 Jackson, Mississippi 39201

CODED

WATER WELL DRILLERS LOG

4-5-75 19 75 Ward Well Drilling Hancock
 date well completed firm name county well located

LANDOWNER: George Dittler
Missouri St.
Bay St. Louis miss
 (mailing address)


description of formations encountered	from	to
<u>fill - clay</u>	<u>0</u>	<u>18</u>
<u>SD</u>	<u>18</u>	<u>85</u>
<u>clay - silt</u>	<u>85</u>	<u>162</u>
<u>fine sand</u>	<u>162</u>	<u>175</u>
<u>clay - silt</u>	<u>175</u>	<u>280</u>
<u>SD</u>	<u>280</u>	<u>300</u>

WELL LOCATION:
 sec 39 T. 8 N R. 14 E
8 miles N of B.S.L.
 (distance) (direction) (nearest town)

WELL PURPOSE: Home
 (home, irrigation, municipal, industrial)

- WELL COMPLETION DATA:
- (1) diameter (inches) 2"
 - (2) total depth (feet) 300
 - (3) static water level (feet) 2 below above top of ground.
 - (4) casing PVC, 295,
 (material) (depth)
 (size) If telescope see back.
 - (5) screen 5', -
 (length) (depth to top)
2", PVC
 (size) (material)
 - (6) pump -, -
 (HP) (yield gpm)
 (type power)
 - (7) electric log NO
 (yes or no)
N/A
 (organization running log)
 - (8) how well bottom plugged BWU

DRILLERS REMARKS: N/A

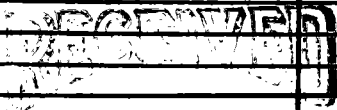

MAY 16 1975

