

HANCOCK
K 312
4-7-75

MISSISSIPPI
BOARD OF WATER COMMISSIONERS
416 North State Street
Jackson, Mississippi 39201

CODED

WATER WELL DRILLERS LOG

4-7-1975 Wood Well Drilling Hancock
date well completed firm name county well located

LANDOWNER: Anthony Mouton

description of formations encountered

from to

Hancock Drive
Bay St. Louis Miss.
(mailing address)

<u>Top Soil - clay</u>	0	15
<u>SD</u>	15	36
<u>clay</u>	36	52
<u>clay - shell</u>	52	95
<u>SD</u>	95	125

WELL LOCATION:

sec. 6 T. 8 N. R. 14 E.
12 miles W of B.S.L.
(distance) (direction) (nearest town)

WELL PURPOSE: Home
(home, irrigation, municipal, industrial)

WELL COMPLETION DATA:

- (1) diameter (inches) 2"
- (2) total depth (feet) 125'
- (3) static water level (feet) 7 ^{below} _{above} top of ground.
- (4) casing PVC 120
(material) (depth)
(size) If telescope see back.
- (5) screen 5' 2"
(length) (depth to top) (size) PVC
(material)
- (6) pump _____ (HP) _____ (yield gpm)
(type power)
- (7) electric log NO
(yes or no)
N/A
(organization running log)
- (8) how well bottom plugged Best


DRILLERS REMARKS: N/A

RECEIVED

MAY 19 1975

If well telescopes please sketch and show depths.

GROUND LEVEL

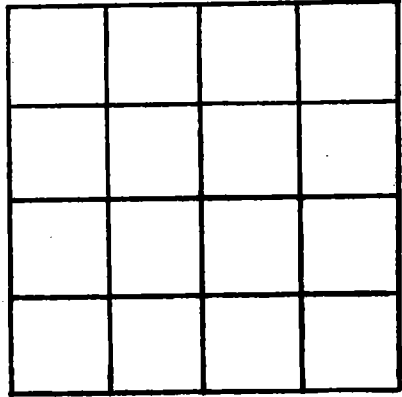

SECTION 6

Please indicate well location X.

ADDITIONAL INFORMATION

If more than one screen, show locations of each on sketch.