

Copy Hancock
R 313
4/25/75

MISSISSIPPI
 BOARD OF WATER COMMISSIONERS
 416 North State Street
 Jackson, Mississippi 39201

CODED

WATER WELL DRILLERS LOG


4/25 1975 Driscoll Water Well Hancock
 date well completed firm name county well located

LANDOWNER: <u>J. Mathews</u>	description of formations encountered	from	to
<u>Share his prop</u>			
<u>By St. Louis Miss</u> (mailing address)	<u>sand soil</u>	<u>0</u>	<u>30</u>
WELL LOCATION: sec <u>20</u> T <u>8</u> R <u>14 E</u> <u>13S</u>	<u>blue soft clay</u>	<u>30</u>	<u>140</u>
<u>5 1/2</u> miles <u>SW</u> of <u>By St</u> (distance) (direction) (nearest town)	<u>cone water pad</u>	<u>140</u>	<u>167</u>
WELL PURPOSE: <u>Home</u> (home, irrigation, municipal, industrial)			
WELL COMPLETION DATA:			
(1) diameter (inches) <u>2"</u>			
(2) total depth (feet) <u>167</u>			
(3) static water level (feet) <u>0</u> below above top of ground.			
(4) casing <u>P.V.C.</u> <u>157</u> (material) (depth)			
<u>2"</u> (size) if telescope see back.			
(5) screen <u>10</u> <u>157</u> (length) (depth to top)			
<u>2</u> <u>P.V.C.</u> (size) (material)			
(6) pump <u>1/2</u> <u>10</u> (HP) (yield gpm)			
<u>Pbel</u> (type power)			
(7) electric log <u>N/A</u> (yes or no)			
<u>N/A</u> (organization running log)			
(8) how well bottom plugged <u>and</u>			
DRILLERS REMARKS:			

JUN 2 1975
 PD. 6

If well telescopes please sketch and show depths.

GROUND LEVEL

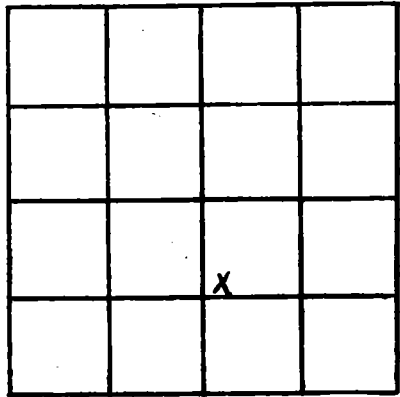

SECTION 20

Please indicate well location X.

ADDITIONAL INFORMATION

If more than one screen,
show locations of each on sketch.