

Hancock
K 315
7-14-75

MISSISSIPPI
BOARD OF WATER COMMISSIONERS
416 North State Street
Jackson, Mississippi 39201

CODED

WATER WELL DRILLERS LOG

7-14-75 date well completed 75 Woodwell Dr. firm name Hancock county well located

LANDOWNER: Jerry Mullins
mole Drive
Bay St. Louis miss
(mailing address)

| description of formations encountered | from | to |
|---------------------------------------|------|-----|
| fill - clay | 0 | 20 |
| clay silt | 20 | 36 |
| clay silt | 36 | 245 |
| sd | 245 | 275 |

WELL LOCATION:
sec. 37 T. 8 N. R. 14 E. 135
1 miles n/w of B.S.L.
(distance) (direction) (nearest town)

WELL PURPOSE: Home
(home, irrigation, municipal, industrial)

WELL COMPLETION DATA:

(1) diameter (inches) 2

(2) total depth (feet) 275

(3) static water level (feet) 2 below top of ground.

(4) casing PVC, 270.
(material) (depth)

(size) If telescope see back.

(5) screen 5
(length) (depth to top)

2" PVC
(size) (material)

(6) pump (HP) (yield gpm)

(type power)

(7) electric log NO
(yes or no)

N/A
(organization running log)

(8) how well bottom plugged BWV

CODED


REGISTERED
REGISTERED
REGISTERED

AUG 18 1975

DRILLERS REMARKS:

If well telescopes please sketch and show depths.

GROUND LEVEL

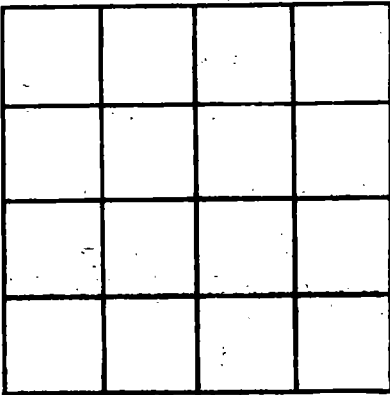

SECTION _____

Please indicate well location X.

ADDITIONAL INFORMATION

If more than one screen, show locations of each on sketch.