

Hancock  
K 317  
7-25-75

MISSISSIPPI  
 BOARD OF WATER COMMISSIONERS  
 416 North State Street  
 Jackson, Mississippi 39201

WATER WELL DRILLERS LOG

CODED

7-25- 1975  
 date well completed

Woodwell Dr.  
 firm name

Hancock  
 county well located

LANDOWNER	description of formations encountered	from	to
<u>Conrad Dupont</u>	<u>Top Soil - clay</u>	<u>0</u>	<u>15</u>
<u>Lake Shore Assoc</u>	<u>sd</u>	<u>15</u>	<u>32</u>
<u>Bay St. Louis mins</u>	<u>clay</u>	<u>32</u>	<u>65</u>
(mailing address)	<u>Red Hill - sd</u>	<u>65</u>	<u>84</u>
	<u>clay</u>	<u>84</u>	<u>96</u>
	<u>sd</u>	<u>96</u>	<u>110</u>

WELL LOCATION:  
 sec 40 T 8 N R 14 E 13S  
to 3 mil. W of B.S.L.  
 (distance) (direction) (nearest town)

WELL PURPOSE: Home  
 (home, irrigation, municipal, industrial)

- WELL COMPLETION DATA:
- (1) diameter (inches) 2"
  - (2) total depth (feet) 110
  - (3) static water level (feet) 2 <sup>below</sup> <sub>above</sub> top of ground.
  - (4) casing PVC, 105  
 (material) (depth)  
 (size) If telescope see back.
  - (5) screen 5', -  
 (length) (depth to top)  
2", PVC  
 (size) (material)
  - (6) pump 1/2, 8  
 (HP) (yield gpm)  
Elco  
 (type power)
  - (7) electric log NO  
 (yes or no)  
N/A  
 (organization running log)
  - (8) how well bottom plugged BWW


CODED

RECEIVED  
 AUG 24 1975

DRILLERS REMARKS:  
Located in Bayou  
Solovix Estate

If well telescopes please sketch and show depths.

GROUND LEVEL

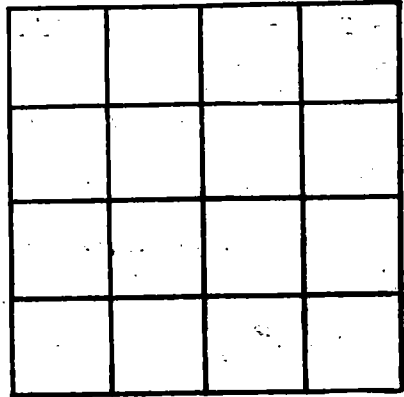

SECTION 40

Please indicate well location X.

ADDITIONAL INFORMATION

If more than one screen, show locations of each on sketch.