

HANCOCK

K318

135 WATER WELL DRILLERS LOG CODEX 303

6-19-61

Date: 6-19, 1961, Driller: Sutter Well Works, Hancock

(Name)

(1) Owner of Land: C. W. Harris  
 (Name)  
Ponchartraine Blvd N.O. La.  
 (Address)  
 (2) Location: 3/4, 8/4, Sec. 34 TS RW,  
3 miles NW, of Bay St Louis,  
 (distance) (direction) (Nearest Town)  
 (3) Topography: flat  
 (Hilly) (Flat) (Level)  
 (4) Purpose of Well: domestic  
 (Domestic Irrigation, Municipal, Industrial, Other)

Description & Color of Materials Sand, Clay, Red Clay, Shell, etc.	Thick- ness Feet	Depth Feet
Clay & sand	80	80
gravel	41	121
Clay	259	380
sand	32	412
Clay	178	590
sand	50	640
COPIED sand	246	886
sand	32	918
Clay	171	1089
sand	55	1144


Information upon completion of well:

(1) Diameter 3 inches.  
 (2) Total Depth 1144 feet.  
 (3) Water level + 40 feet above below top of ground.  
 (4) Cased to all, Size 3"  
 (5) Screen: Size 3", Length 20'  
 (6) Were any formations sealed against pollution?  
yes,  no.

If YES depth of formation \_\_\_\_\_

Why \_\_\_\_\_

Drillers Remarks: \_\_\_\_\_

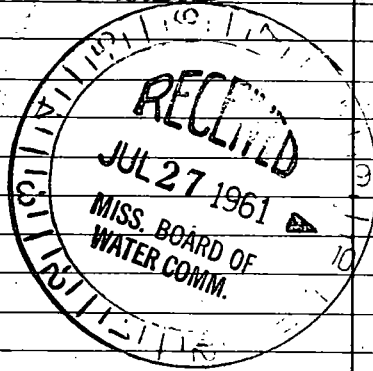

(Use Back Side)

Well No.

1000

1000

