

HANCOCK
K 320

MISSISSIPPI BOARD OF WATER COMMISSIONERS


1-26-62 135 WATER WELL DRILLERS LOGGED 336

Date: 1-26, 1962, Driller: Sutter Well Works County Hancock
(Name)

(1) Owner of Land	Description & Color of Materials Sand, Clay, Red Clay, Shell, etc.	Thick- ness Feet	Depth Feet
Louise Craddock (Name)	Clay	15	15
Klen Miss. (Address)	Sand	70	85
(2) Location: SE 1/4, SE 1/4, Sec. 34 T85 R14 W	Clay	155	240
3 miles W of Bay St. Louis (distance) (direction) (Nearest Town)	Sand	25	265
(3) Topography: level (Hilly) (Flat) (Level)	Clay	71	336
(4) Purpose of Well: domestic (Domestic Irrigation Municipal, Industrial, Other)	Sand	29	365
	Clay	45	410
	Sand	65	475
	Clay	130	605
	Sand	90	695
	Clay	40	735
	Sand	20	755
	CODED Clay	85	840
	Sand	55	895
	Clay	160	1055
	Sand	65	1120

Information upon completion of well:

- (1) Diameter 3 inches.
- (2) Total Depth 1120 feet.
- (3) Water Level + 36 feet above ground.
- (4) Cased to all, Size 3"
- (5) Screen: Size 3", Length 20'
- (6) Were any formations sealed against pollution?
yes, no.

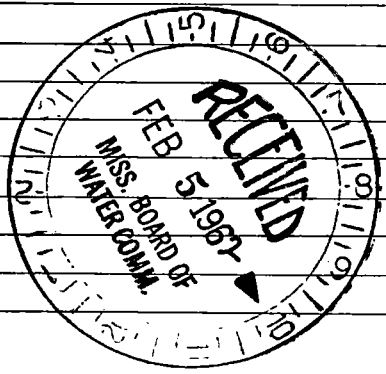

(Use Back Side)

Well No.

