

HANCOCK
K 321
1-20-64¹³⁵

MISSISSIPPI BOARD OF WATER COMMISSIONERS

WATER WELL DRILLERS LOG

CODED

Date: 1-20, 19 64, Driller: Sutton Well Works County Leflore
(Name)

(1) Owner of Land: James Hale
(Name)
Rt 1 Box 440 Bay St Louis
(Address)

(2) Location: MW 1/4, NW 1/4, Sec. 35 T8S R 14 W
2 miles W of Bay St Louis
(distance) (direction) (Nearest Town)

(3) Topography: flat
(Hilly) (Flat) (Level)

(4) Purpose of Well: domestic
(Domestic Irrigation
Municipal, Industrial, Other)

Description & Color of Materials Sand, Clay, Red Clay, Shell, etc.	Thick- ness Feet	Depth Feet
<u>Sandy clay</u>	<u>94</u>	<u>94</u>
<u>sand</u>	<u>41</u>	<u>135</u>
<u>Clay - thin sand str</u>	<u>286</u>	<u>421</u>
<u>Clay</u>	<u>147</u>	<u>568</u>
<u>CODED</u>	<u>64</u>	<u>632</u>
<u>Clay</u>	<u>328</u>	<u>950</u>
<u>sand</u>	<u>29</u>	<u>979</u>
<u>Clay</u>	<u>24</u>	<u>1003</u>
<u>sand</u>	<u>75</u>	<u>1078</u>

Information upon completion of well:

(1) Diameter 2 inches.

(2) Total Depth 1078 feet.

(3) Water Level + 35 feet above ~~below~~ top of ground.

(4) Cased to all, Size 2"


(5) Screen: Size 2", Length 20'

(6) Were any formations sealed against pollution?
 yes, no.

If YES depth of formation surface

Why _____

Drillers Remarks: _____

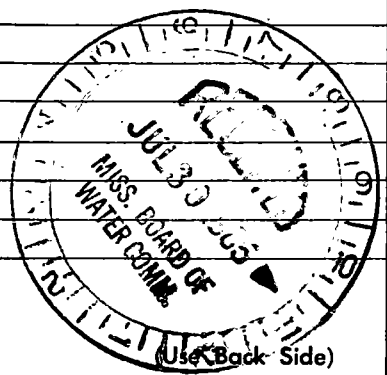

Well No. _____

Handwritten notes and scribbles at the top of the page, including the number '2' and some illegible characters.

Main body of handwritten text, appearing as a list or series of notes. Includes the number '1000' and other faint, illegible markings.