

HANCOCK
K 323 135
1-18-65

WATER WELL DRILLERS LOG CODED *R*

Date: 1-18-65, 1965, Driller: Sutton Well Works County Hancock
(Name)

(1) Owner of Land: O. K. Bush
(Name)
Rt 3 Laurel, Miss.
(Address)

(2) Location: NE 1/4, SW 1/4, Sec. 46 T8S R14W
3 miles W, of Bay St Louis
(distance) (direction) (Nearest Town)

(3) Topography: flat
(Hill) (Flat) (Level)

(4) Purpose of Well: domestic
(Domestic Irrigation
Municipal, Industrial, Other)

Description & Color of Materials Sand, Clay, Red Clay, Shell, etc.	Thick- ness Feet	Depth Feet
Clay	18	18
sand	18	36
clayed	20	56
clayed sand st	324	380
sand	35	415
clay-sand st	79	494
clay	18	512
sand	50	562

Information upon completion of well:

(1) Diameter 3 inches.

(2) Total Depth 562 feet.

(3) Water Level + 24 above feet below top of ground.


(4) Cased to all, Size 3

(5) Screen: Size 3", Length 15'

(6) Were any formations sealed against pollution?
 yes, no.

If YES depth of formation _____
 Why _____

Drillers Remarks: _____

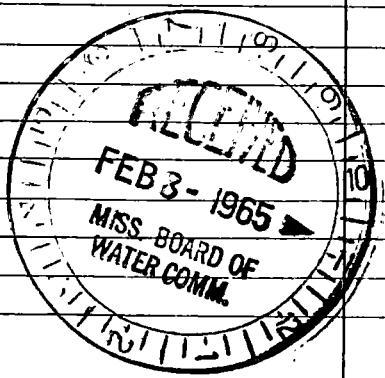

(Use Back Side)

Well No.

