

HANCOCK  
K 327

MISSISSIPPI BOARD OF WATER COMMISSIONERS

7-13-65 135 WATER WELL DRILLERS LOG

CODED

Date: 7-13, 1965, Driller: Intertec Well Works County Hancock  
(Name)

(1) Owner of Land: Jack Litchfield  
(Name)  
Bay St. Louis, Miss.  
(Address)

(2) Location: NW 1/4, NW 1/4, Sec. 35 T85R 14 W  
2 miles W, of Bay St. Louis  
(distance) (direction) (Nearest Town)

(3) Topography: flat  
(Hilly) (Flat) (Level)

(4) Purpose of Well: domestic  
(Domestic Irrigation  
Municipal, Industrial, Other)

Description & Color of Materials Sand, Clay, Red Clay, Shell, etc.	Thick- ness Feet	Depth Feet
Clay	5	5
sand	46	51
clay	39	90
sand	43	133
Clay	96	229
Clay	103	332
sand	17	349
Clay	68	417
sand	79	496
Clay	77	573
Clay	67	640
Clay	182	822
sand	21	843
Clay	116	967
Red	25	992
Clay	44	1036
sand	101	1137

Information upon completion of well:

(1) Diameter 2 1/2 inches.

(2) Total Depth 1137 feet.

(3) Water Level + 34 feet above below top of ground.

(4) Cased to all, Size 2 1/2"


(5) Screen: Size 2 1/2", Length 20'

(6) Were any formations sealed against pollution?  
 yes,  no.

If YES depth of formation \_\_\_\_\_

Why \_\_\_\_\_

Drillers Remarks: \_\_\_\_\_

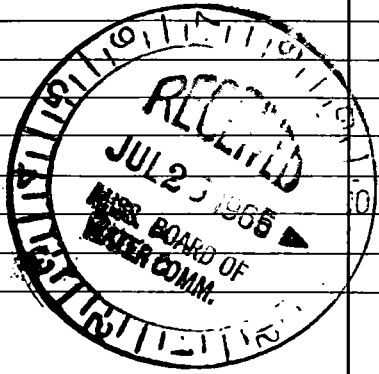

(Use Back Side)

Well No.

