

Hancock
K 329

8-12-66

MISSISSIPPI BOARD OF WATER COMMISSIONERS

CODED

135

WATER WELL DRILLERS LOG

Date: 8-12, 1966, Driller: Sutter Well Works Wash County Hancock
(When well drilled) (Name) (Where well is located)

(1) Owner of Land: Jack Garriga
(Name)
Bay St. Louis Miss.
(Address)

(2) Location: SW 1/4, SW 1/4, Sec. 36 T85R14W
1 miles W of Bay St. Louis
(distance) (direction) (Nearest Town)

(3) Topography: level
(Hilly) (Flat) (Level)

(4) Purpose of Well: domestic
(Domestic Irrigation
Municipal, Industrial, Other)


Description & Color of Materials Sand, Clay, Red Clay, Shell, etc.	Thick- ness Feet	Depth Feet
<u>sand</u>	<u>38</u>	<u>38</u>
<u>Clay</u>	<u>17</u>	<u>55</u>
<u>sand</u>	<u>90</u>	<u>145</u>
<u>Clay</u>	<u>45</u>	<u>190</u>
<u>red sand</u>	<u>36</u>	<u>226</u>
<u>Clay</u>	<u>192</u>	<u>418</u>
<u>sand</u>	<u>125</u>	<u>543</u>
<u>Clay</u>	<u>72</u>	<u>615</u>
<u>CODED sand</u>	<u>49</u>	<u>664</u>
<u>Clay</u>	<u>98</u>	<u>762</u>
<u>sand</u>	<u>40</u>	<u>792</u>
<u>Clay</u>	<u>408</u>	<u>1200</u>
<u>sand</u>	<u>57</u>	<u>1257</u>

Information upon completion of well:

- (1) Diameter 2 inches.
- (2) Total Depth 1257 feet.
- (3) Water Level +24 feet above top of ground.
- (4) Cased to all, Size 2"
- (5) Screen: Size 2", Length 20'
- (6) Were any formations sealed against pollution?
no

If YES depth of formation _____
Why _____

Drillers Remarks: _____
Yield in gpm: 34
Size pump: none
Type power: _____

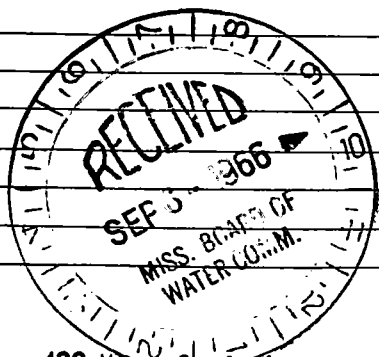

[Faint, illegible handwriting on a grid background]