

HANCOCK
 K332
 5-16-66

MISSISSIPPI BOARD OF WATER COMMISSIONERS

135

WATER WELL DRILLERS LOG

CODED

Date: 5-16, 1966, Driller: Latter Well Works County Hancock
 (When well drilled) (Name) (Where well is located)

(1) Owner of Land: August Usher
 (Name)
Lakeshore, Miss.
 (Address)

(2) Location: SW 1/4, NE 1/4, Sec. 8 T28R14W
1 miles N of Clement
 (distance) (direction) (Nearest Town)
Barber

(3) Topography: flat
 (Hilly) (Flat) (Level)

(4) Purpose of Well: domestic
 (Domestic Irrigation
 Municipal, Industrial, Other)

Description & Color of Materials Sand, Clay, Red Clay, Shell, etc.	Thick- ness Feet	Depth Feet
Clay	19	19
Sand	38	57
Clay	32	89
Sand	16	105
Clay - Sand streaks	175	280
Sand - some gravel	64	344
Clay - sand streaks	301	645
Sand	40	685
Clay	16	701
Sand - CODED fine	57	758
Clay	94	852
fine Sand	33	885
Sand	61	946

Information upon completion of well:

(1) Diameter 2 inches.

(2) Total Depth 946 feet.

(3) Water Level + 21 feet above top of ground.

(4) Cased to ape, Size 2"

(5) Screen: Size 2", Length 20'

(6) Were any formations sealed against pollution?
 _____ yes, no.

If YES depth of formation _____


Why _____

Drillers Remarks: _____

Yield in gpm: 30

Size pump: none

Type power: _____

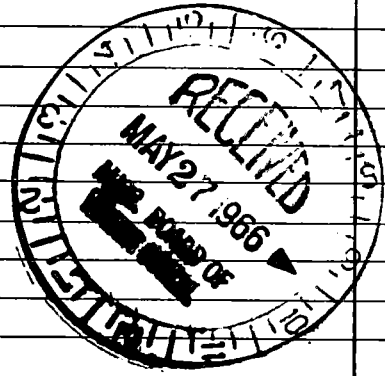

Handwritten text at the top of the page, possibly a title or header, which is mostly illegible due to fading and noise.

Main body of handwritten text, appearing to be a list or series of entries. The text is very faint and difficult to decipher.

Continuation of the handwritten text, showing some faint numerical values and possibly a table structure.

Bottom section of the page with handwritten text, including what appears to be a signature or a final note.