

Hancock
 MK335
 7-67

MISSISSIPPI
 BOARD OF WATER COMMISSIONERS
 416 North State Street
 Jackson, Mississippi 39201

CODED

135 WATER WELL DRILLERS LOG

7-7 1967 Sutter Well Works Hancock
 date well completed firm name county well located

LANDOWNER: Laton Weinberg

description of formations encountered

from to

Dumber Ave.

Bay St. Louis, Miss.
 (mailing address)

WELL LOCATION:

sec 4 T 9 R 14
 S W
2 1/2 miles N of Waveland
 (distance) (direction) (nearest town)

WELL PURPOSE: home
 (home, irrigation, municipal, industrial)

WELL COMPLETION DATA:


- (1) diameter (inches) 2
- (2) total depth (feet) 1151
- (3) static water level (feet) 40 above
 top of ground.
- (4) casing galv. 1131'
 (material) (depth)
- 2"
 (size) If telescope see back.
- (5) screen 20' 1131'
 (length) (depth to top)
- 2" Stainless Steel
 (size) (material)
- (6) pump 1/2 40 gpm flow
 (HP) (yield gpm)
- elec
 (type power)
- (7) electric log no
 (yes or no)

(organization running log)

(8) how well bottom plugged B.P. Value


DRILLERS REMARKS:

Clay	0	10
sand	10	34
Clay - soft/sandy	34	98
clay	98	158
sand	158	179
Clay	179	270
sand & gravel	270	307
Clay	307	513
sand	513	552
Clay	552	609
sand	609	649
Clay CODED	649	738
sand	738	773
Clay	773	844
sand	844	947
Clay	947	1100
sand	1100	1151

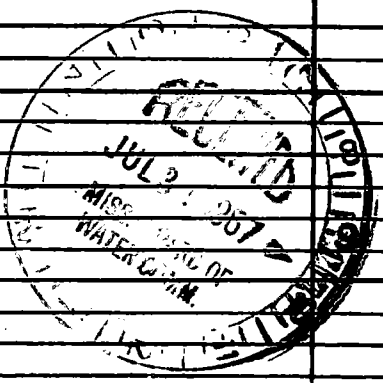

If well telescopes please sketch and show depths.

GROUND LEVEL

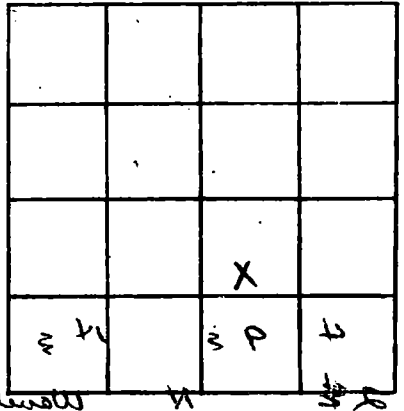

SECTION 4

Please indicate well location X.

ADDITIONAL INFORMATION

If more than one screen, show locations of each on sketch.