

Hancock
K 340
7-3-75

MISSISSIPPI
BOARD OF WATER COMMISSIONERS
416 North State Street
Jackson, Mississippi 39201

CODED

WATER WELL DRILLERS LOG

7-3-1975 date well completed 25 Wood Well Dr. firm name Hancock county well located

LANDOWNER: B. E. Boudo
Seventh St.
Bay St. Louis, Miss
(mailing address)

description of formations encountered	from	to
Top Soil - clay	0	25
SC	25	32
clay	32	86
SC	86	118
clay - dirt	118	220
SC	220	245

WELL LOCATION:
sec 30 T 8 N R 14 E 135
8 miles W of B.S.L.
(distance) (direction) (nearest town)

WELL PURPOSE: Home
(home, irrigation, municipal, industrial)

WELL COMPLETION DATA:

(1) diameter (inches) 2"

(2) total depth (feet) 245

(3) static water level (feet) 1 ^{below} top of ground

(4) casing PVC, 240
(material) (depth)
(size) If telescope see back.

(5) screen 5' (length) (depth to top)
2" PVC
(size) (material)

(6) pump (HP) (yield gpm)
(type power)

(7) electric log NO (yes or no)
N/A
(organization running log)

(8) how well bottom plugged BWV


CODED

DRILLERS REMARKS: N/A

REGISTERED

If well telescopes please sketch and show depths.

GROUND LEVEL

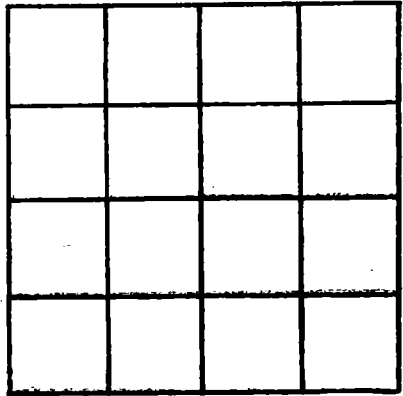

SECTION 30

Please indicate well location X.

ADDITIONAL INFORMATION

If more than one screen, show locations of each on sketch.