

Hancock  
K 341  
7-2-75

MISSISSIPPI  
 BOARD OF WATER COMMISSIONERS  
 416 North State Street  
 Jackson, Mississippi 39201

**CODED**

WATER WELL DRILLERS LOG

7-2- 1975 Woodwell Dg. Hancock  
 date well completed firm name county well located

LANDOWNER: A. S. Burnett  
Sylvia St.  
Bay St. Louis miss  
 (mailing address)

description of formations encountered	from	to
<u>Top Soil - clay</u>	<u>0</u>	<u>18</u>
<u>clay</u>	<u>18</u>	<u>35</u>
<u>clay</u>	<u>35</u>	<u>90</u>
<u>SD</u>	<u>90</u>	<u>110</u>

WELL LOCATION:  
 sec 40 T 8 N R 14 E 135  
0.4 miles W of B.S.L.  
 (distance) (direction) (nearest town)

WELL PURPOSE: Home  
 (home, irrigation, municipal, industrial)


- WELL COMPLETION DATA:
- (1) diameter (inches) 2"
  - (2) total depth (feet) 110
  - (3) static water level (feet) 3 <sup>below</sup> <sub>above</sub> top of ground.
  - (4) casing PVC, 105,  
 (material) (depth)  
     If telescope see back.  
 (size)
  - (5) screen 5,       
 (length) (depth to top)  
2", PVC  
 (size) (material)
  - (6) pump     ,       
 (HP) (yield gpm)  
      
 (type power)
  - (7) electric log NO  
 (yes or no)  
N/A  
 (organization running log)
  - (8) how well bottom plugged BWU

**CODED**

DRILLERS REMARKS: N/A

If well telescopes please sketch and show depths.

GROUND LEVEL

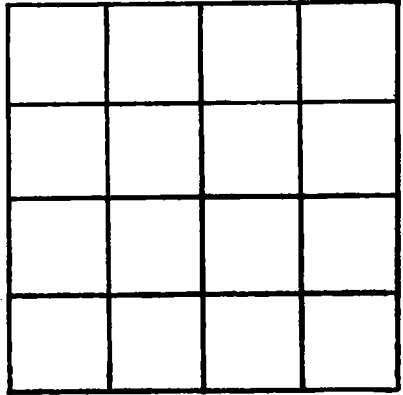

SECTION 40

Please indicate well location X.

ADDITIONAL INFORMATION

If more than one screen, show locations of each on sketch.