

Harrod
K343
6-2-75

MISSISSIPPI
 BOARD OF WATER COMMISSIONERS
 416 North State Street
 Jackson, Mississippi 39201

CODED

WATER WELL DRILLERS LOG

6-2- 1975 Wood well Drilling Harrod
 date well completed firm name county well located

LANDOWNER: S. J. Pollanen
Harrison St.
Bay St. Louis, Miss.
 (mailing address)

description of formations encountered	from	to
<u>Top Soil - clay</u>	<u>0</u>	<u>17</u>
<u>sd</u>	<u>17</u>	<u>35</u>
<u>clay</u>	<u>35</u>	<u>57</u>
<u>Red Hard - sd</u>	<u>57</u>	<u>86</u>
<u>with clay & silt</u>		
<u>sd</u>	<u>86</u>	<u>410</u>
<u>sd</u>	<u>410</u>	<u>425</u>


WELL LOCATION:
 sec. 32 T. 8 N R. 14 E 135
1/2 miles N of B.S.L.
 (distance) (direction) (nearest town)

WELL PURPOSE: Home
 (home, irrigation, municipal, industrial)

- WELL COMPLETION DATA:
- (1) diameter (inches) 2
 - (2) total depth (feet) 450
 - (3) static water level (feet) 2 below top of ground. above
 - (4) casing PVC, 440,
 (material) (depth)
 - If telescope see back.
 (size)
 - (5) screen 10', —
 (length) (depth to top)
2", PVC
 (size) (material)
 - (6) pump —, —
 (HP) (yield gpm)
—
 (type power)
 - (7) electric log NO
 (yes or no)
N/A
 (organization running log)
 - (8) how well bottom plugged BWC


DRILLERS REMARKS: N/A

CODED

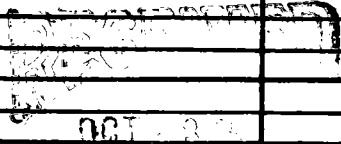

If well telescopes please sketch and show depths.

GROUND LEVEL

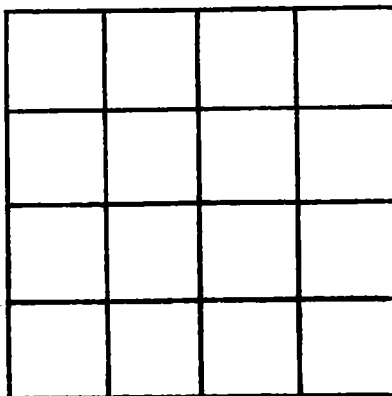

SECTION 37

Please indicate well location X.

ADDITIONAL INFORMATION

If more than one screen, show locations of each on sketch.