

Hancock
K 344
9-19-75

MISSISSIPPI
 BOARD OF WATER COMMISSIONERS
 416 North State Street
 Jackson, Mississippi 39201

WATER WELL DRILLERS LOG

9-19 1975 Lumplin Well Co. Hancock
 date well completed firm name county well located


LANDOWNER: Paul Lecher
8811 Bunker Hill Road
New Orleans, La.
 (mailing address)

description of formations encountered	from to	
Clay	0	10
Sand	10	55
Clay	55	140
Sand	140	178

WELL LOCATION:
 sec. 17 T. 8 N. R. 14 E.
8 miles NW of Bay St. Louis
 (distance) (direction) (nearest town)

WELL PURPOSE: Home
 (home, irrigation, municipal, industrial)

WELL COMPLETION DATA:
 (1) diameter (inches) 2"
 (2) total depth (feet) 178'
 (3) static water level (feet) 0' below above top of ground.
 (4) casing P.V.C., 175'
 (material) (depth)
2" If telescope see back.
 (size)
 (5) screen 5, 173
 (length) (depth to top)
2", P.V.C.
 (size) (material)
 (6) pump 1/2, 300
 (HP) (yield gpd)
Elec.
 (type power)
 (7) electric log No.
 (yes or no)
No.
 (organization running log)
 (8) how well bottom plugged Sand Shovel

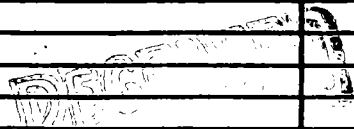

DRILLERS REMARKS:

MISS. BD. OF WATER COMM.

