

Hancock
K-362
5-26-80

MISSISSIPPI
 BOARD OF WATER COMMISSIONERS
 416 North State Street
 Jackson, Mississippi 39201

CODED

WATER WELL DRILLERS LOG

5-26 1980 Ward Well Dg. Hancock
 date well completed firm name county well located

LANDOWNER: Ray Charles
Good St.
Bay St. Louis Mrs.
 (mailing address)

WELL LOCATION:
 sec 37 T 8 N R 14 E
5 miles N of Bisite
 (distance) (direction) (nearest town)

WELL PURPOSE: 17 inch
 (home, irrigation, municipal, industrial)

WELL COMPLETION DATA:

(1) diameter (inches) 2"

(2) total depth (feet) 525

(3) static water level (feet) 10 below above
 top of ground.

(4) casing PVC, 515,
 (material) (depth)
 (size) If telescope see back.

(5) screen 10', -
 (length) (depth to top)
2", PVC
 (size) (material)

(6) pump owner -
 (HP) (yield gpm)
 (type power)

(7) electric log NO
 (yes or no)
N/A
 (organization running log)

(8) how well bottom plugged BWU

description of formations encountered	from	to
Fill - clay	0	21
sd	21	36
clay	36	97
Sdy - clay	97	148
Bill - clay	148	225
Fine - sd	225	238
bill - clay	238	440
Fine - sd	440	456
bill - clay	456	495
Coarse sd	495	525

CODED


DEPT. OF NATURAL RESOURCES
 BUREAU OF LAND & WATER RESOURCES

JUL - 2 1980
 RECEIVED

DRILLERS REMARKS: will flowing approx 3 PSI
15 G.P.M. U

If well telescopes please sketch and show depths.

GROUND LEVEL

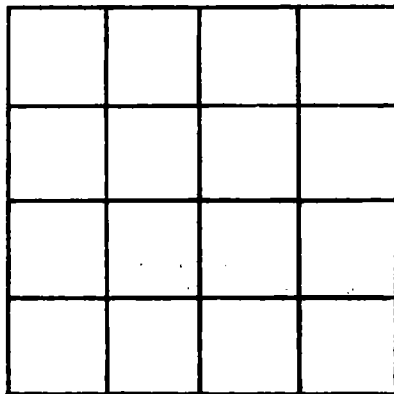

SECTION 5

Please indicate well location X.

ADDITIONAL INFORMATION

If more than one screen, show locations of each on sketch.