

MISSISSIPPI DEPARTMENT OF NATURAL RESOURCES

Bureau of Land and Water Resources

Southport Mall

P.O. Box 10631

Jackson, Mississippi 39209

WATER WELL DRILLERS LOG

CODED

HANCOCK
K 366
10-1-80

10-1-1980 date well completed 80 WARD WELL DLG. firm name HANCOCK county well located

LANDOWNER	description of formations encountered	from	to
CONNIE BOHTE			
Good ST.	fill-clay	0	23
	sd	23	45
BAY ST. LOUIS, MS.	clay	45	106
(mailing address)	sd	106	145
WELL LOCATION:	Pen Gravel	145	153
sec. 27 T-8 N R-14 E	clay-silt	153	410
4 miles N/W of B.S.L.	fine sd	410	428
(distance) (direction) (nearest town)	clay-silt	428	505
	coarse sd	505	550

WELL PURPOSE: HOME
(home, irrigation, municipal, industrial)

WELL COMPLETION DATA:

- (1) diameter (inches) 2"
- (2) total depth (feet) 550'
- (3) static water level (feet) 8' below top of ground. (above)
- (4) casing PVC, 540'
(material) (depth)
- if telescope see back.
(size)
- (5) screen 10', -
(length) (depth to top)
- 2", PVC
(size) (material)
- (6) pump N/A, -
(HP) (yield gpm)
- (type power)
- (7) electric log NO
(yes or no)
- N/A
(organization running log)
- (8) how well bottom plugged BWU

DEPT. OF NATURAL RESOURCES
BUREAU OF LAND & WATER RESOURCES


NOV - 3 1980

DRILLERS REMARKS: 3 PSI
AT well held - approx.
10 G.P.M. natural flow.

RECEIVED

If well telescopes please sketch and show depths.

GROUND LEVEL

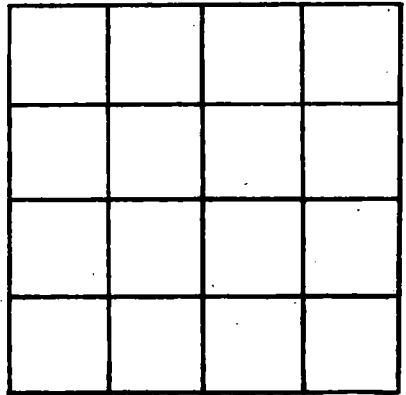

SECTION 27

Please indicate well location X.

ADDITIONAL INFORMATION

If more than one screen, show locations of each on sketch.