

Hancock
K 374
6-16-81

MISSISSIPPI
BOARD OF WATER COMMISSIONERS
416 North State Street
Jackson, Mississippi 39201

CODED

WATER WELL DRILLERS LOG

6-16 19 81 Penton Well Serv Hancock
date well completed firm name county well located

LANDOWNER: Billy Meitzler
206 S. Jackson Av.
Picayune Ms.
(mailing address)

description of formations encountered	from	to
Surface Clay	0	30
Sand	30	50
Clay	50	140
silt	140	165
Clay	165	300
Sand	300	350
Clay	350	540
Sand	540	630

WELL LOCATION:
sec 39 T 8 R 14 S W
2 miles NW of Bay St Louis
(distance) (direction) (nearest town)

WELL PURPOSE: Home
(home, irrigation, municipal, industrial)

WELL COMPLETION DATA:

(1) diameter (inches) 2

(2) total depth (feet) 630

(3) static water level (feet) Flow below top of ground.

(4) casing PVC 620
(material) (depth)
2 if telescope see back.
(size)


(5) screen 10' 620
(length) (depth to top)
2 PVC
(size) (material)

(6) pump (HP) (yield gpm)
(type power)

(7) electric log NO
(yes or no)
(organization running log)

(8) how well bottom plugged BW, V/L

CODED

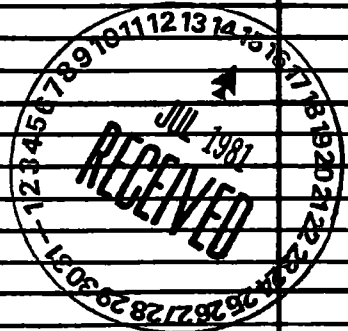

DRILLERS REMARKS:

If well telescopes please sketch and show depths.

GROUND LEVEL

SECTION

Please indicate well location X.

ADDITIONAL INFORMATION

If more than one screen, show locations of each on sketch.