

MISSISSIPPI DEPARTMENT OF NATURAL RESOURCES

Bureau of Land and Water Resources

Southport Mall

P.O. Box 10631

Jackson, Mississippi 39209

**CODED**

WATER WELL DRILLERS LOG

HANCOCK

K 381

3/3/83

3-3-1983

83 Coast Water Well Sew. Hancock

date well completed

firm name

county well located

LANDOWNER:

Robert Ketzner

description of formations encountered

from

to

409 Shawsbury Ct.  
Jefferson, La. 70121  
(mailing address)

Top soil

0 3'

gray clay

3' 5'

Blue Clay & Chen shell

5' 100'

Gray coarse sand & gravel

100' 122'

Blue Clay

122' 150'

Gray coarse sand & gravel

150' 220'

Blue Clay & gravel

220' 278'

Blue Clay

278' 498'

Blue Clay & chunk of sand

498' 502'

Blue Clay

502' 583'

Gray coarse sand & wood

583' 611'

Blue Clay & (chunk) sand

611' 626'

Blue Clay

626' 633'

Gray fine sand

633' 656'

Blue Clay

656' 784'

Gray coarse sand

784' 870'

Blue Clay

870' 1034'

Gray coarse sand

1034' 1097'

WELL LOCATION:

sec. 6 T 9 S R 14 W  
3 miles W of Waveland  
(distance) (direction) (nearest town)

WELL PURPOSE:

Home  
(home, irrigation, municipal, industrial)

WELL COMPLETION DATA:

(1) diameter (inches) 2"

(2) total depth (feet) 1097'

(3) static water level (feet) 15' below top of ground

(4) casing PUC 1077'  
(material) (depth)

2" (size) if telescope see back.

(5) screen 20' 1077'  
(length) (depth to top)

2" (size) PUC (material)

(6) pump 1/2 hp. 35  
(HP) (yield gpm)

sheer (type power)

(7) electric log No. CODED  
(yes or no)

(organization running log)

(8) flow well bottom plugged  
back wash blue

(organization running log)

(8) flow well bottom plugged  
back wash blue

(organization running log)


DRILLERS REMARKS:

JUN 24 1983

**RECEIVED**

If well telescopes please sketch and show depths.

GROUND LEVEL

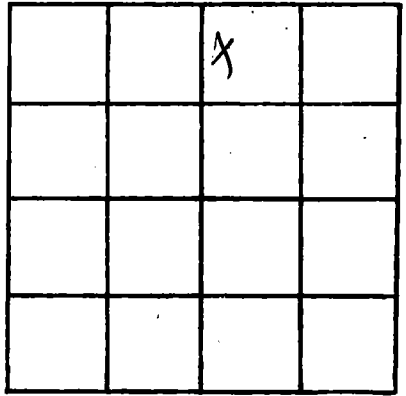

SECTION 6

Please indicate well location X.

**ADDITIONAL INFORMATION**

A series of horizontal lines for entering additional information.

If more than one screen, show locations of each on sketch.