

MISSISSIPPI DEPARTMENT OF NATURAL RESOURCES

Bureau of Land and Water Resources

Southport Mall

P.O. Box 10631

Jackson, Mississippi 39209

WATER WELL DRILLERS LOG

**CODED**

K 384  
Hancock  
8-17-83

17 Aug. 1983 Ward Well Dlg. Hancock  
date well completed firm name county well located

LANDOWNER	description of formations encountered	from	to
Sand Truitt			
Good St.	Fill-clay	0	18
Bay St. Sam, Mrs.	sd	18	45
(mailing address)	Clay	45	76
	sd-Red Gravel	76	88
	Clay	88	106
	sd	106	147
	Clay-silt	147	485
	Coarse sd	485	525

WELL LOCATION:  
sec. 37 T. 8 N. R. 13 E. S. 14 W.  
2 miles N/W of B.S. Co.  
(distance) (direction) (nearest town)

WELL PURPOSE: Home  
(home, irrigation, municipal, industrial)

WELL COMPLETION DATA:

(1) diameter (inches) 2'  
(2) total depth (feet) 525  
(3) static water level (feet) 10 below top of ground.  
(4) casing PVC, 505 (material), (depth)  
(size) if telescope see back.  
(5) screen 20' (length), (depth to top)  
2" (size), PVC (material)  
(6) pump 1 1/2 (HP), 40 (yield gpm)  
Elec. (type power)  
(7) electric log NO (yes or no)  
N/A (organization running log)  
(8) how well bottom plugged BWU

DRILLERS REMARKS: N/A

**CODED**


DEPT. OF NATURAL RESOURCES  
BUREAU OF LAND & WATER RESOURCES

OCT 17 1983

**RECEIVED**

If well telescopes please sketch and show depths.

GROUND LEVEL

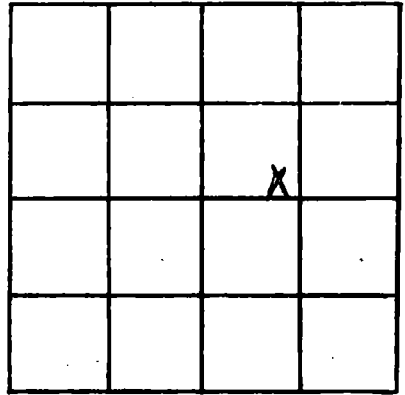

SECTION \_\_\_\_\_

Please indicate well location X.

ADDITIONAL INFORMATION

If more than one screen, show locations of each on sketch.