

MISSISSIPPI DEPARTMENT OF NATURAL RESOURCES

Bureau of Land and Water Resources

Southport Mall

P.O. Box 10631

Jackson, Mississippi 39209

WATER WELL DRILLERS LOG

CODED

K389
HANCOCK
4-25-84

4-25-1984 date well completed Ward Well Dlg. firm name Hancock county well located

LANDOWNER: Etienne Baudouin
Waver St.
Bay St. Louis, ms.
(mailing address)

description of formations encountered	from	to
top Soil - clay	0	12
sd	12	48
clay	48	105
sd	105	128
clay	128	157
Pls. Material - sd	157	179

WELL LOCATION:
sec. 6 T 9 N R. 14 E
8 miles W of Waverland
(distance) (direction) (nearest town)

WELL PURPOSE: Home
(home, irrigation, municipal, industrial)

- WELL COMPLETION DATA:
- (1) diameter (inches) 2"
 - (2) total depth (feet) 179
 - (3) static water level (feet) 12 ^{below} above top of ground.
 - (4) casing PVC 169
(material) (depth)
If telescope see back.
(size)
 - (5) screen 10' -
(length) (depth to top)
2" PVC
(size) (material)
 - (6) pump 1/2 10
(HP) (yield gpm)
Elec.
(type power)
 - (7) electric log NO
(yes or no)
N/A
(organization running log)
 - (8) how well bottom plugged BWU

DRILLERS REMARKS: N/A


DEPT. OF NATURAL RESOURCES
BUREAU OF LAND & WATER RESOURCES

JUN 15 1984

RECEIVED

If well telescopes please sketch and show depths.

GROUND LEVEL

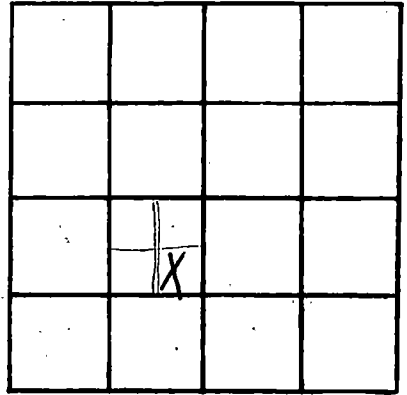

SECTION 6

Please indicate well location X.

ADDITIONAL INFORMATION

If more than one screen, show locations of each on sketch.