

MISSISSIPPI DEPARTMENT OF NATURAL RESOURCES
Bureau of Land and Water Resources
 Southport Mall
 P.O. Box 10631
 Jackson, Mississippi 39209 **CODED**
WATER WELL DRILLERS LOG

HANCOCK
K 390

4-31-84 19 McMiel Well Hancock
 date well completed firm name county well located

LANDOWNER: <u>William Baucke</u>	description of formations encountered	from	to
<u>1309 Redwood Dr.</u> <u>Harvey La, 70058</u> (mailing address)			
WELL LOCATION: sec. <u>9</u> T. <u>8</u> N. R. <u>13</u> E. S. <u>1</u> W. <u>10</u> miles <u>N</u> of <u>BSL</u> (distance) (direction) (nearest town)	<u>Sand</u>	<u>0</u>	<u>20</u>
	<u>mud</u>	<u>20</u>	<u>40</u>
	<u>mud & sand</u>	<u>40</u>	<u>60</u>
	<u>Sand</u>	<u>60</u>	<u>80</u>
	<u>mud</u>	<u>80</u>	<u>100</u>
	<u>mud & sand</u>	<u>100</u>	<u>140</u>
	<u>mud & sand</u>	<u>140</u>	<u>250</u>
	<u>mud & sand</u>	<u>250</u>	<u>300</u>
	<u>sand</u>	<u>300</u>	<u>380</u>

WELL PURPOSE:
 (home, irrigation, municipal, industrial)

WELL COMPLETION DATA:

- (1) diameter (inches) 2"
- (2) total depth (feet) 380'
- (3) static water level (feet) 30 below top of ground
- (4) casing sch 40, 370'
 (material) (depth)
 If telescope see back.
- (5) screen 10', 370'
 (length) (depth to top)
2", sch 80 ledot
 (size) (material)
- (6) pump 1 8
 (HP) (yield gpm)
elec.
 (type power)
- (7) electric log
 (yes or no)
 (organization running log)
- (8) how well bottom plugged sand
seal


CODED

DEPT. OF NATURAL RESOURCES
 BUREAU OF LAND & WATER RESOURCES
 AUG 13 1984
RECEIVED

DRILLERS REMARKS:

If well telescopes please sketch and show depths.

GROUND LEVEL

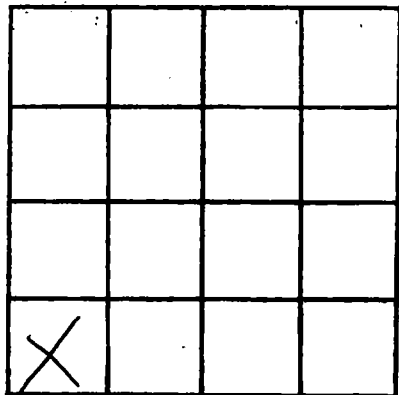

SECTION _____

Please indicate well location X.

ADDITIONAL INFORMATION

If more than one screen, show locations of each on sketch.