

MISSISSIPPI DEPARTMENT OF NATURAL RESOURCES
Bureau of Land and Water Resources
 Southport Mall
 P.O. Box 10631
 Jackson, Mississippi 39209
WATER WELL DRILLERS LOG

CODED

HANCOCK
K 391

July 20 1984 Wood Well Dr. Hancock
 date well completed firm name county well located

LANDOWNER: Floyd Breaux
Rt. 4, Box 210
Box St. Louis, Mo.
 (mailing address)
WELL LOCATION:
 sec. 26 T. 8 N. R. 14 E.
2 miles N/W of P.S.I.
 (distance) (direction) (nearest town)

description of formations encountered	from	to
<u>fill - clay</u>	<u>0</u>	<u>18</u>
<u>sd</u>	<u>18</u>	<u>46</u>
<u>clay</u>	<u>46</u>	<u>75</u>
<u>sd</u>	<u>75</u>	<u>84</u>
<u>clay</u>	<u>84</u>	<u>110</u>
<u>sd</u>	<u>110</u>	<u>138</u>
<u>clay - sd</u>	<u>138</u>	<u>266</u>
<u>sd</u>	<u>266</u>	<u>295</u>
<u>clay - sd</u>	<u>295</u>	<u>328</u>
<u>sd</u>	<u>328</u>	<u>413</u>
<u>clay - sd</u>	<u>413</u>	<u>505</u>
<u>sd</u>	<u>505</u>	<u>550</u>

WELL PURPOSE: Home
 (home, irrigation, municipal, industrial)

- WELL COMPLETION DATA:**
- diameter (inches) 2"
 - total depth (feet) 550
 - static water level (feet) 8 below top of ground. above
 - casing PVC, 530
 (material) (depth)
 (size) if telescope see back.
 - screen 20' -
 (length) (depth to top)
2" PVC
 (size) (material)
 - pump Onsen -
 (HP) (yield gpm)
 (type power)
 - electric log NO
 (yes or no)
N/A
 (organization running log)
 - how well bottom plugged BWU

CODED

DEPT. OF NATURAL RESOURCES
 BUREAU OF LAND & WATER RESOURCES


SEP - 4 1984

RECEIVED

DRILLERS REMARKS: natural flow
156 PM - 3 PSI

If well telescopes please sketch and show depths.

GROUND LEVEL

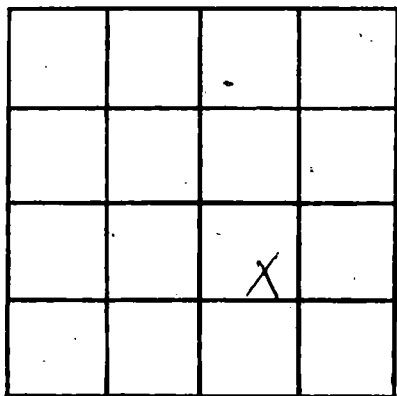

SECTION _____

Please indicate well location X.

ADDITIONAL INFORMATION

If more than one screen,
show locations of each on sketch.