

HANCOCK
R 392
6-10-76

MISSISSIPPI
 BOARD OF WATER COMMISSIONERS CODED.
 416 North State Street
 135 Jackson, Mississippi 39201

WATER WELL DRILLERS LOG

6-10-76 19 ward well drilling Hancock
 date well completed firm name county well located

LANDOWNER: E.N. Spence
pt. 3, Box 50
Bay St. Louis miss
 (mailing/address)

description of formations encountered	from	to
<u>tan gal-clay</u>	<u>0</u>	<u>14</u>
<u>Black sd.</u>	<u>14</u>	<u>37</u>
<u>gray clay</u>	<u>37</u>	<u>76</u>
<u>shovel clay</u>	<u>76</u>	<u>92</u>
<u>sd - fine clay - silt</u>	<u>92</u>	<u>256</u>
<u>sd</u>	<u>256</u>	<u>278</u>
<u>clay - silt</u>	<u>278</u>	<u>325</u>
<u>sd</u>	<u>325</u>	<u>367</u>
<u>clay - silt</u>	<u>367</u>	<u>420</u>
<u>sd</u>	<u>420</u>	<u>435</u>
<u>clay - silt</u>	<u>435</u>	<u>472</u>
<u>sd</u>	<u>472</u>	<u>480</u>
<u>clay - silt</u>	<u>480</u>	<u>540</u>
<u>sd - coarse</u>	<u>540</u>	<u>576</u>

WELL LOCATION:
 sec 37 T 8 N R 14 E
2 miles N/W of B.S.L
 (distance) (direction) (nearest town)

WELL PURPOSE: Home
 (home, irrigation, municipal, industrial)

WELL COMPLETION DATA:

(1) diameter (inches) 2"

(2) total depth (feet) 576

(3) static water level (feet) 15 below above top of ground.

(4) casing PVC, 561,
 (material) (depth)
2"
 (size) If telescope see back.

(5) screen 15, -
 (length) (depth to top)
2", PVC-Rib
 (size) (material)

(6) pump pepper
 (HP) (yield gpm)
-
 (type power)

(7) electric log NO
 (yes or no)
N/A
 (organization running log)

(8) how well bottom plugged B.W.U.


DRILLERS REMARKS: N/A

RECEIVED
 JUL 19 1976

MISS. BD. OF WATER COMMISSIONERS

If well telescopes please sketch and show depths.

GROUND LEVEL

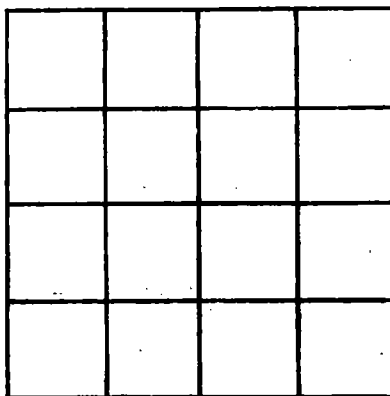

SECTION 32

Please indicate well location X.

ADDITIONAL INFORMATION

If more than one screen, show locations of each on sketch.