

HANCOCK
K 397

**MISSISSIPPI
BOARD OF WATER COMMISSIONERS CODED**
416 North State Street
Jackson, Mississippi 39201

WATER WELL DRILLERS LOG

6-18 1978 Wood Well Dlg. Hancock
 date well completed firm name county well located

LANDOWNER: F. J. Spiccola
Rt. 4 - Box 9 (Goods)
Boy St. Louis, Miss
 (mailing/address)


WELL LOCATION:
 sec. 42 T-8 N R-14 E
2 miles N of B.S.L.
 (distance) (direction) (nearest town)

WELL PURPOSE: Home
 (home, irrigation, municipal, industrial)

WELL COMPLETION DATA:

- (1) diameter (inches) 2"
- (2) total depth (feet) 545
- (3) static water level (feet) 15 below above top of ground.
- (4) casing Galv. 530
 (material) (depth)
 If telescope see back.
 (size)
- (5) screen 15 -
 (length) (depth to top)
2" S.S.
 (size) (material)
- (6) pump - -
 (HP) (yield gpm)
 (type power)
- (7) electric log NO
 (yes or no)
N/A
 (organization running log)
- (8) how well bottom plugged B.W.V.

description of formations encountered	from	to
clay	0	14
B. black sd.	14	26
gray clay	26	56
sd. - black sand	56	60
clay - silt	60	265
shaly sd.	265	273
clay	273	332
fine sd.	332	335
clay	335	412
fine sd.	412	435
clay	435	437
med. sd	437	452
clay	452	495
coarse sd.	495	545

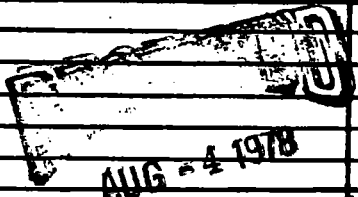


MISS. Bd. OF WATER COMM.

DRILLERS REMARKS: N/A

If well telescopes please sketch and show depths.

GROUND LEVEL

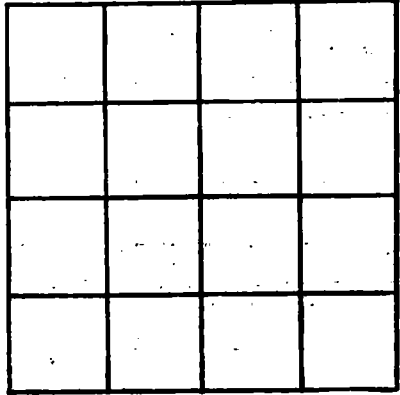

SECTION 42

Please indicate well location X.

ADDITIONAL INFORMATION

If more than one screen, show locations of each on sketch.