

HANCOCK
K 398
8-19-78

**MISSISSIPPI
BOARD OF WATER COMMISSIONERS CODED**
416 North State Street
Jackson, Mississippi 39201

WATER WELL DRILLERS LOG

8-19-78 date well completed 28 Wardwell Dly. firm name Hancock county well located

LANDOWNER: Mr. Carr
Washington Rd.
Bay St. Louis, Miss
(mailing address)

WELL LOCATION:
sec. 26 T. 9 N. R. 14 E.
3 miles N/W of B.S.L.
(distance) (direction) (nearest town)

WELL PURPOSE: Home
(home, irrigation, municipal, industrial)

WELL COMPLETION DATA:

(1) diameter (inches) 2"

(2) total depth (feet) 555

(3) static water level (feet) 15 below top of ground. above

(4) casing PVC, 540,
(material) (depth)
— If telescope see back.
(size)

(5) screen 15, —
(length) (depth to top)
2", PVC
(size) (material)

(6) pump —, —
(HP) (yield gpm)
—
(type power)

(7) electric log NO
(yes or no)
M/A
(organization running log)

(8) how well bottom plugged BWW

description of formations encountered	from	to
Clay	0	20
Sd	20	37
Clay	37	105
Fine Sd.	105	126
Clay-Silt	126	184
Fine Sd.	184	205
Clay-Silt	205	310
Sd	310	327
Clay-Silt	327	415
Sd	415	438
Clay-Silt	438	525
Coarse Sd.	525	555

DRILLERS REMARKS: M/A


RECEIVED

SEP 21 1978

MISS. BD. OF WATER COMMISSIONERS

If well telescopes please sketch and show depths.

GROUND LEVEL

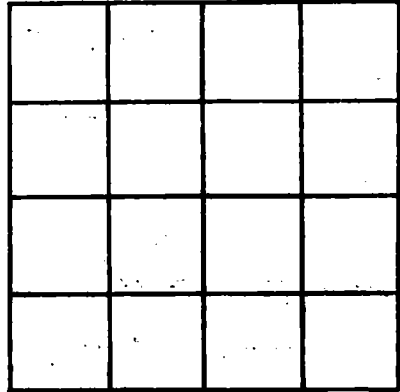

SECTION 26

Please indicate well location X.

ADDITIONAL INFORMATION

If more than one screen, show locations of each on sketch.