

MISSISSIPPI DEPARTMENT OF NATURAL RESOURCES

Bureau of Land and Water Resources

Southport Mall

P.O. Box 10631

7  
CODED

Jackson, Mississippi 39209

WATER WELL DRILLERS LOG

HANCOCK  
K401

7-9-

1980 Wardwell Dr.

Hancock

date well completed

firm name

county well located

LANDOWNER: S. L. Crawford

description of formations encountered

from

to

Skyline Drive  
Box St. Louis mo  
(mailing address)

<u>Fill - clay</u>	<u>0</u>	<u>21</u>
<u>sd</u>	<u>21</u>	<u>46</u>
<u>clay - silt</u>	<u>46</u>	<u>95</u>
<u>fine sd</u>	<u>95</u>	<u>116</u>
<u>clay - silt</u>	<u>116</u>	<u>150</u>
<u>fine sd</u>	<u>150</u>	<u>167</u>
<u>clay - silt</u>	<u>167</u>	<u>362</u>
<u>fine sd</u>	<u>362</u>	<u>395</u>
<u>clay - silt</u>	<u>395</u>	<u>505</u>
<u>Red gravel - sd</u>	<u>505</u>	<u>546</u>

WELL LOCATION:

sec. 22 T 8 N R 14 E  
37 (S) 14 (W)  
1.37 miles NW of Bisli  
(distance) (direction) (nearest town)

WELL PURPOSE: Home  
(home, irrigation, municipal, industrial)

WELL COMPLETION DATA:

- (1) diameter (inches) 2 "
- (2) total depth (feet) 546
- (3) static water level (feet) 10 below top of ground. above
- (4) casing PVC, 536  
(material) (depth)
- (5) screen 10', 536  
(length) (depth to top)
- (6) pump 2", PVC  
(size) (material)
- (7) pump 1/2, 10  
(HP) (yield gpm)
- (8) electric log elec.  
(type power)
- (9) electric log no  
(yes or no)
- (10) NIA  
(organization running log)
- (11) how well bottom plugged BWU

DRILLERS REMARKS:

Well loc. in Spider  
hole sudu.


DEPT. OF NATURAL RESOURCES  
BUREAU OF LAND & WATER RESOURCES

AUG 21 1980

RECEIVED

If well telescopes please sketch and show depths.

GROUND LEVEL

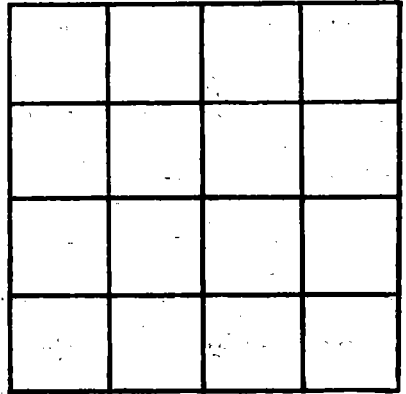

SECTION 27

Please indicate well location X.

ADDITIONAL INFORMATION

If more than one screen, show locations of each on sketch.