

Hancock
K 406
7-14-81

MISSISSIPPI
BOARD OF WATER COMMISSIONERS
416 North State Street
Jackson, Mississippi 39201

CODED

WATER WELL DRILLERS LOG

7-14
date well completed

1981 Ward Well Ols.
firm name

Hancock
county well located

LANDOWNER: B. Borchert
Royal Oaks Plantation
Box St. Louis, ms.
(mailing address)


WELL LOCATION:
sec. 25 T. 8 N R. 13 E
⑤ ④
_____ miles _____ of _____
(distance) (direction) (nearest town)

WELL PURPOSE:
(home, irrigation, municipal, industrial)

WELL COMPLETION DATA:
(1) diameter (inches) 4"
(2) total depth (feet) 717
(3) static water level (feet) 18 ^{below} ~~above~~ top of ground.
(4) casing Steel 697
(material) (depth)
_____ if telescope see back.
(size)
(5) screen 20' _____
(length) (depth to top)
4" Stainless Steel
(size) (material)
(6) pump N/A _____
(HP) (yield gpm)
_____ (type power)
(7) electric log NO
(yes or no)
N/A
(organization running log)
(8) how well bottom plugged BW

description of formations encountered	from	to
Clay	0	10
SD	10	40
Clay	40	70
SD - Red gravel	70	115
Clay	115	178
SD - Red gravel	178	236
Clay	236	378
Coarse sd	378	409
Clay	409	626
SD	626	636
Clay	636	655
Coarse sd	655	721

DRILLERS REMARKS: Subsoil

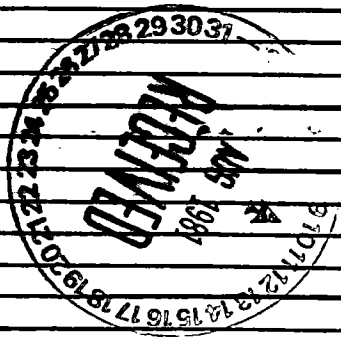

If well telescopes please sketch and show depths.

GROUND LEVEL

SECTION _____

Please indicate well location X.

ADDITIONAL INFORMATION

Well Head Run: -8-10/52
G.L.M. = 70

If more than one screen, show locations of each on sketch.