

Hancock  
K 406  
7-8-81

MISSISSIPPI  
BOARD OF WATER COMMISSIONERS  
416 North State Street  
Jackson, Mississippi 39201

CODED.


WATER WELL DRILLERS LOG

7-8-81  
7-8-81  
date well completed

1981 Ward Well Drg.  
firm name

Hancock  
county well located

| LANDOWNER:   | description of formations encountered | from | to  |
|--|---------------------------------------|------|-----|
| Cannt Zim  | top Soil - clay                       | 0    | 26  |
| mole Drive   | sd                                    | 26   | 46  |
| Boy St. Sours, ms,                                   | Red gravel                            | 46   | 61  |
| (mailing address)                                    | clay                                  | 61   | 115 |
| WELL LOCATION:                                       | sd                                    | 115  | 132 |
| sec <del>28</del> T 8 N R B 14                       | clay - silt                           | 132  | 264 |
| 42 5   | fine sd                               | 265  | 284 |
| 7 miles N/W of B.S.L.                                | clay - silt                           | 284  | 370 |
| (distance) (direction) (nearest town)                | sc                                    | 370  | 420 |
| WELL PURPOSE: Home                                   | clay - silt                           | 420  | 515 |
| (home, irrigation, municipal, industrial)            | coral sd - Red gravel                 | 515  | 567 |
| WELL COMPLETION DATA:                                |                                       |      |     |
| (1) diameter (inches) 2"                             |                                       |      |     |
| (2) total depth (feet) 567                           |                                       |      |     |
| (3) static water level (feet) 10 below top of ground |                                       |      |     |
| (4) casing PVC 567 (material) (depth)                |                                       |      |     |
| (size) if telescope see back.                        |                                       |      |     |
| (5) screen 20' (length) (depth to top)               |                                       |      |     |
| 2" PVC (size) (material)                             |                                       |      |     |
| (6) pump 0 (HP) (yield gpm)                          |                                       |      |     |
| (type power)   |                                       |      |     |
| (7) electric log NO (yes or no)                      |                                       |      |     |
| N/A (organization running log)                       |                                       |      |     |
| (8) how well bottom plugged BWW                      |                                       |      |     |
| DRILLERS REMARKS:                                    |                                       |      |     |

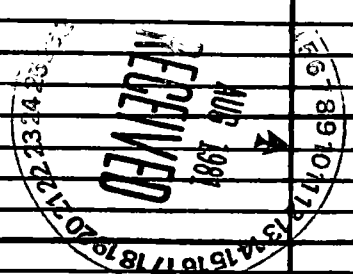

If well telescopes please sketch and show depths.

GROUND LEVEL

|  |  |  |  |
|--|--|--|--|
|  |  |  |  |
|  |  |  |  |
|  |  |  |  |
|  |  |  |  |

SECTION 22

Please indicate well location X.

ADDITIONAL INFORMATION

If more than one screen, show locations of each on sketch.

