

Hancock
K 411

MISSISSIPPI
BOARD OF WATER COMMISSIONERS
416 North State Street
Jackson, Mississippi 39201

CODED

WATER WELL DRILLERS LOG

2-8-1982
date well completed

82 Ward Well Drg.
firm name

Hancock
county well located

LANDOWNER:	description of formations encountered	from	to
Ed Binet Fiber St.	Top Soil - clay	0	21
Boyd St. Louis, mo. (mailing address)	sd	21	36
	clay - silt	36	97
	sd	97	128
	clay - silt	128	505
WELL LOCATION:	Water		
sec. 37 T. 8 N. R. 13 E. 5 miles N/W of B.S.L. (distance) (direction) (nearest town)	Water		
WELL PURPOSE:			
Home (home, irrigation, municipal, industrial)			
WELL COMPLETION DATA:			
(1) diameter (inches) 2"			
(2) total depth (feet) 546			
(3) static water level (feet) 10 below top of ground.			
(4) casing PVC, 536 (material) (depth)			
(size) If telescope see back.			
(5) screen 10' - (length) (depth to top)			
2" Stainless Steel (size) (material)			
(6) pump Runer - (HP) (yield gpm)			
(type power)			
(7) electric log NO (yes or no)			
N/A (organization running log)			
(8) how well bottom plugged B/W			
DRILLERS REMARKS: N/A			


DEPT. OF NATURAL RESOURCES
BUREAU OF LAND & WATER RESOURCES

MAR 12 1982

RECEIVED

If well telescopes please sketch and show depths.

GROUND LEVEL

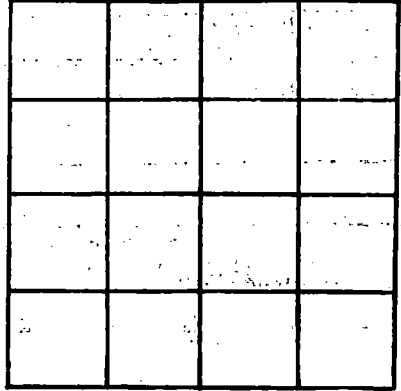

SECTION 37

Please indicate well location X.

ADDITIONAL INFORMATION

If more than one screen, show locations of each on sketch.