

MISSISSIPPI DEPARTMENT OF NATURAL RESOURCES

Bureau of Land and Water Resources

Southport Mall

P.O. Box 10631

Jackson, Mississippi 39209

WATER WELL DRILLERS LOG

CODED

Hancock
K 416

11-17-

1982 *Wood Well Dly.*

Hancock

date well completed

firm name

county well located

LANDOWNER:

Event Underwood

Short cut Rd.

Waveland ms.

(mailing address)

WELL LOCATION:

sec. 33 T. 8 N. R. 18 E. *1/4*

2 miles *N/W* of *Waveland*

(distance)

(direction)

(nearest town)

description of formations encountered

top soil - clay

sd

clay

sd

clay

sd - red gravel

clay - silt

crack sd

from

to

0 18

18 46

46 58

58 86

86 95

95 147

147 555

555 586

WELL PURPOSE:

(home, irrigation, municipal, industrial)

None

WELL COMPLETION DATA:

(1) diameter (inches) 2"

(2) total depth (feet) 586

(3) static water level (feet) 10 *below* above top of ground.

(4) casing PVC 566
 (material) (depth)

(size) If telescope see back.

(5) screen 20' -
 (length) (depth to top)

2" PVC
 (size) (material)

(6) pump owner
 (HP) (yield gpm)

(type power)

(7) electric log NO
 (yes or no)

N/A
 (organization running log)

(8) how well bottom plugged BWU

DRILLERS REMARKS:

N/A

CODED


RECEIVED

DEC 20 1982

DEPT. OF NATURAL RESOURCES
 BUREAU OF LAND & WATER RESOURCES

If well telescopes please sketch and show depths.

GROUND LEVEL

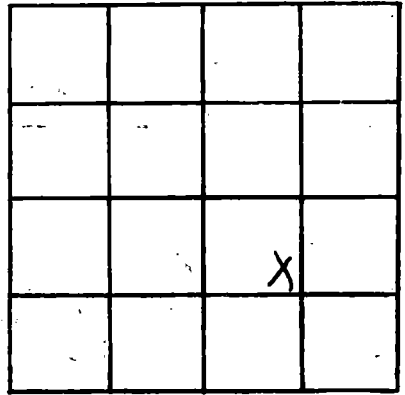

SECTION 33

Please indicate well location X.

ADDITIONAL INFORMATION

A series of horizontal lines for writing additional information.

If more than one screen, show locations of each on sketch.