

Hancock  
R 417

MISSISSIPPI DEPARTMENT OF NATURAL RESOURCES  
Bureau of Land and Water Resources  
Southport Mall  
P.O. Box 10631  
Jackson, Mississippi 39209 CODED  
WATER WELL DRILLERS LOG

12-14 1982 Ward Well Dr. Hancock  
date well completed firm name county well located

LANDOWNER: Patrice Toal  
Rt. 4, Bay 222A (Lake Dr.)  
Bay St. Louis ms.  
(mailing address)

WELL LOCATION:  
42 26 T 8 N R 12 1/2 E  
4 miles N/W of B.S.L.  
(distance) (direction) (nearest town)

WELL PURPOSE: None  
(home, irrigation, municipal, industrial)

WELL COMPLETION DATA:  
(1) diameter (inches) 2"  
(2) total depth (feet) 546  
(3) static water level (feet) 15 below above  
top of ground.  
(4) casing PVC, 536  
(material) (depth)  
- If telescope see back.  
(size)  
(5) screen 10'  
(length) (depth to top)  
2", Stainless Steel  
(size) (material)  
(6) pump owner  
(HP) (yield gpm)  
-  
(type power)  
(7) electric log NO  
(yes or no)  
N/A  
(organization running log)  
(8) how well bottom plugged BWU

description of formations encountered	from	to
Clay	0	21
Sd	21	37
Clay	37	66
Red Marvel - Sd	66	84
Clay	84	98
Sd	98	134
Clay - silt	134	376
Sd	376	420
Clay - silt	420	505
Coarse Sd	505	546

DRILLERS REMARKS: N/A


DEPT. OF NATURAL RESOURCES  
BUREAU OF LAND & WATER RESOURCES

JAN 31 1983

RECEIVED

If well telescopes please sketch and show depths.

GROUND LEVEL

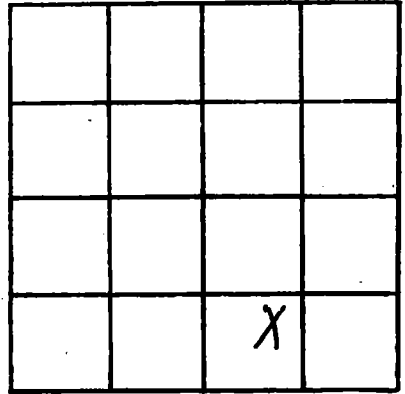

SECTION \_\_\_\_\_

Please indicate well location X.

ADDITIONAL INFORMATION

If more than one screen, show locations of each on sketch.