

MISSISSIPPI DEPARTMENT OF NATURAL RESOURCES

Bureau of Land and Water Resources

Southport Mall

P.O. Box 10631

Jackson, Mississippi 39209

WATER WELL DRILLERS LOG

CODED

Hancock  
K 419

8-15-

19

83 Ward Well Drg.

Hancock

date well completed

firm name

county well located

LANDOWNER: Arnold Stone  
Rt. 4, Box 209  
Bay St. Louis, Miss  
(mailing address)

description of formations encountered

from

to

WELL LOCATION:  
sec. 22 T. 8 N R. 13 E  
3 miles N of B.S.L.  
(distance) (direction) (nearest town)

<u>Full-clay</u>	<u>0</u>	<u>22</u>
<u>SD</u>	<u>22</u>	<u>48</u>
<u>Clay</u>	<u>48</u>	<u>67</u>
<u>SD - Ken Marvel</u>	<u>67</u>	<u>85</u>
<u>Clay - Silt</u>	<u>85</u>	<u>154</u>
<u>Fine SD</u>	<u>154</u>	<u>172</u>
<u>Clay - Silt</u>	<u>172</u>	<u>265</u>
<u>Fine SD</u>	<u>265</u>	<u>288</u>
<u>Clay Silt</u>	<u>288</u>	<u>376</u>
<u>SD</u>	<u>376</u>	<u>404</u>
<u>Clay - Silt</u>	<u>404</u>	<u>505</u>
<u>Coast SD</u>	<u>505</u>	<u>546</u>

WELL PURPOSE: None  
(home, irrigation, municipal, industrial)

WELL COMPLETION DATA:

(1) diameter (inches) 2"

(2) total depth (feet) 54.6

(3) static water level (feet) 10 below above top of ground.

(4) casing PVC, 52.6,  
(material) (depth)  
- If telescope see back.  
(size)

(5) screen 20', -  
(length) (depth to top)  
2", PVC  
(size) (material)

(6) pump 1/2, 12  
(HP) (yield gpm)  
Electric  
(type power)

(7) electric log no  
(yes or no)  
N/A  
(organization running log)

(8) how well bottom plugged BWV

CODED

DEPT. OF NATURAL RESOURCES  
BUREAU OF LAND & WATER RESOURCES

SEP 15 1983


DRILLERS REMARKS: 20 GPM -  
2 PSI

RECEIVED

If well telescopes please  
sketch and show depths.

3100

GROUND LEVEL

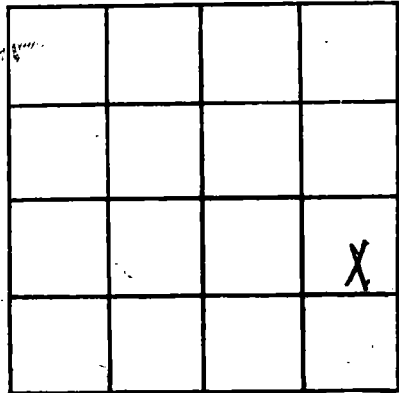

SECTION \_\_\_\_\_

Please indicate well location X.

ADDITIONAL INFORMATION

If more than one screen,  
show locations of each on sketch.