

**MISSISSIPPI DEPARTMENT OF NATURAL RESOURCES**  
**Bureau of Land and Water Resources**  
 Southport Mall  
 P.O. Box 10631  
 Jackson, Mississippi 39209  
**WATER WELL DRILLERS LOG**

**CODED**

Hancock  
K 420

10-7- 1983 Ward Well Dlg. Hancock  
 date well completed firm name county well located

LANDOWNER: George Cassard  
Waveland ave.  
Waveland, ms.  
 (mailing address)

WELL LOCATION:  
 sec. 34 T 8 N R 14 E  
1 miles N of Waveland  
 (distance) (direction) (nearest town)

WELL PURPOSE: None  
 (home, irrigation, municipal, industrial)

**WELL COMPLETION DATA:**

- (1) diameter (inches) 2"
- (2) total depth (feet) 1019
- (3) static water level (feet) 10 below top of ground.
- (4) casing PVC, 989,  
 (material) (depth)  
 (size) If telescope see back.
- (5) screen 30, -  
 (length) (depth to top)  
2", PVC  
 (size) (material)
- (6) pump owner -  
 (HP) (yield gpm)  
 (type power)
- (7) electric log NO  
 (yes or no)  
N/A  
 (organization running log)
- (8) how well bottom plugged BVD

description of formations encountered	from	to
Top Soil - clay	0	16
sd	16	38
Clay	38	125
Red Shale - sd	128	194
Clay - Silt	194	540
sd	540	565
Clay - Silt	565	770
sd	770	815
Clay - Silt	815	930
sd	930	976
Clay	976	984
sd	984	1019

DEPT. OF NATURAL RESOURCES  
 BUREAU OF LAND & WATER RESOURCES


NOV 22 1983

**RECEIVED**

DRILLERS REMARKS: N/A

If well telescopes please sketch and show depths.

GROUND LEVEL

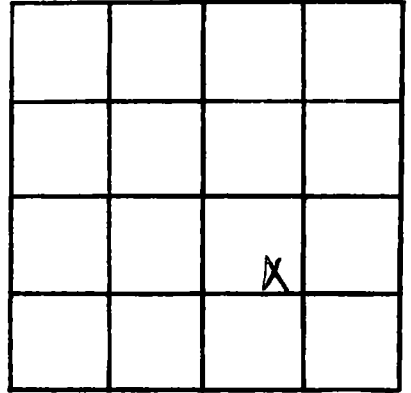

SECTION 34

Please indicate well location X.

ADDITIONAL INFORMATION

If more than one screen,  
show locations of each on sketch.