

Hancock
K 421

MISSISSIPPI DEPARTMENT OF NATURAL RESOURCES
 Bureau of Land and Water Resources
 Southport Mall
 P.O. Box 10631
 Jackson, Mississippi 39209
WATER WELL DRILLERS LOG

CODED

2-25-1984 date well completed Ward Well Dlg. firm name Hancock county well located

LANDOWNER: Robert Dugger
Marden Dale
Box St. Louis ms.
 (mailing address)

WELL LOCATION:
 sec. 27 T. 8 N. R. 13 E.
3 miles N/W of B.S.L.
 (distance) (direction) (nearest town)

WELL PURPOSE: None
 (home, irrigation, municipal, industrial)

- WELL COMPLETION DATA:
- (1) diameter (inches) 2"
 - (2) total depth (feet) 558
 - (3) static water level (feet) 6 below top of ground. above
 - (4) casing PVC, 538,
(material) (depth)
 if telescope see back.
(size)
 - (5) screen 20',
(length) (depth to top)
2", PVC
(size) (material)
 - (6) pump owner,
(HP) (yield gpm)

(type power)
 - (7) electric log NO
(yes or no)
N/A
(organization running log)
 - (8) how well bottom plugged BWV


description of formations encountered	from	to
<u>fill - clay</u>	<u>0</u>	<u>19</u>
<u>SD</u>	<u>19</u>	<u>44</u>
<u>clay</u>	<u>44</u>	<u>98</u>
<u>SD</u>	<u>98</u>	<u>123</u>
<u>clay</u>	<u>126</u>	<u>147</u>
<u>SD</u>	<u>147</u>	<u>176</u>
<u>clay - silt</u>	<u>176</u>	<u>265</u>
<u>SD</u>	<u>265</u>	<u>304</u>
<u>clay - silt</u>	<u>304</u>	<u>375</u>
<u>clay SD</u>	<u>375</u>	<u>414</u>
<u>clay - silt</u>	<u>414</u>	<u>485</u>
<u>SD</u>	<u>485</u>	<u>558</u>

DRILLERS REMARKS: 15 G.P.M.
3 P.S.L.

DEPT. OF NATURAL RESOURCES
 BUREAU OF LAND & WATER RESOURCE
 MAR 19 1984
RECEIVED

If well telescopes please sketch and show depths.

GROUND LEVEL

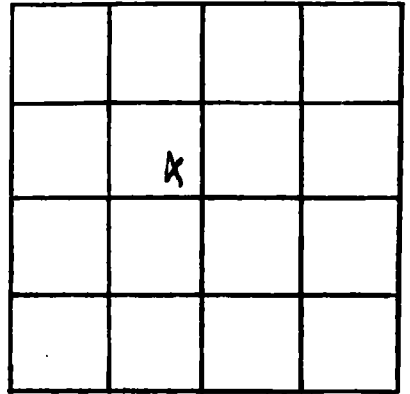

SECTION 27

Please indicate well location X.

ADDITIONAL INFORMATION

If more than one screen,
show locations of each on sketch.