

MISSISSIPPI DEPARTMENT OF NATURAL RESOURCES
Bureau of Land and Water Resources
 Southport Mall
 P.O. Box 10631
 Jackson, Mississippi 39209
WATER WELL DRILLERS LOG

Hancock
K 423

CODED

3-2- 1984 Wood Well Drilling Hancock
 date well completed firm name county well located

LANDOWNER: Mr. J. Fave
Garden Rd.
Bay St. Louis, ms.
 (mailing address)

WELL LOCATION:
 sec. 27 T. 8 N. R. 12 E.
4 miles N/W of B.S.L.
 (distance) (direction) (nearest town)

WELL PURPOSE: Home
 (home, irrigation, municipal, industrial)

- WELL COMPLETION DATA:
- diameter (Inches) 2"
 - total depth (feet) 567
 - static water level (feet) 5 below top of ground
 - casing PVC, 547,
 (material) (depth)
 (size) If telescope see back.
 - screen 20', -
 (length) (depth to top)
2", PVC
 (size) (material)
 - pump owner -
 (HP) (yield gpm)
 (type power)
 - electric log NO
 (yes or no)
N/A
 (organization running log)
 - how well bottom plugged BWV

description of formations encountered	from	to
<u>Fill - clay</u>	<u>0</u>	<u>12</u>
<u>sd</u>	<u>12</u>	<u>42</u>
<u>clay</u>	<u>42</u>	<u>84</u>
<u>sd</u>	<u>84</u>	<u>92</u>
<u>clay</u>	<u>92</u>	<u>105</u>
<u>fine sd</u>	<u>105</u>	<u>118</u>
<u>clay - silt</u>	<u>118</u>	<u>147</u>
<u>sd</u>	<u>147</u>	<u>168</u>
<u>clay - silt</u>	<u>167</u>	<u>262</u>
<u>sd</u>	<u>262</u>	<u>293</u>
<u>clay - silt</u>	<u>293</u>	<u>376</u>
<u>sd</u>	<u>376</u>	<u>414</u>
<u>clay - silt</u>	<u>414</u>	<u>515</u>
<u>sd</u>	<u>515</u>	<u>567</u>

DRILLERS REMARKS: 12 GPM -
natural flow.


DEPT. OF NATURAL RESOURCES
 BUREAU OF LAND & WATER RESOURCES

APR 23 1984

RECEIVED

If well telescopes please sketch and show depths.

GROUND LEVEL

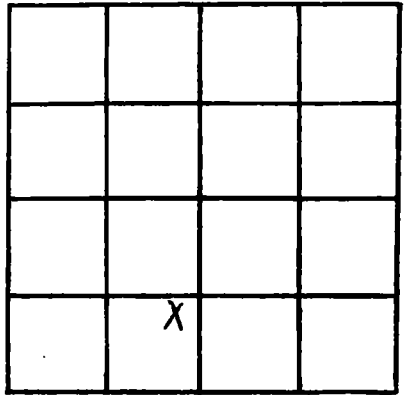

SECTION 27

Please indicate well location X.

ADDITIONAL INFORMATION

If more than one screen,
show locations of each on sketch.