

**MISSISSIPPI DEPARTMENT OF NATURAL RESOURCES**  
**Bureau of Land and Water Resources**  
 Southport Mall  
 P.O. Box 10631 **CODED**  
 Jackson, Mississippi 39209  
**WATER WELL DRILLERS LOG**

Harcoak  
K 424

5-5- 1984 Wood Well Drg. Hancock  
 date well completed firm name county well located

LANDOWNER: Ronald Bennett  
Manhattan St.  
Buy St. Louis mo.  
 (mailing address)

WELL LOCATION:  
 sec. 39 T 8 N R 18 E  
7 miles N/W of Ward  
 (distance) (direction) (nearest town)

WELL PURPOSE: Home  
 (home, irrigation, municipal, industrial)

WELL COMPLETION DATA:

(1) diameter (inches) 2"

(2) total depth (feet) 630

(3) static water level (feet) 10 below above  
 top of ground.

(4) casing PVC, 610,  
 (material) (depth)  
— if telescope see back.  
 (size)

(5) screen 20', —  
 (length) (depth to top)  
2", PVC  
 (size) (material)

(6) pump —, —  
 (HP) (yield gpm)  
—  
 (type power)

(7) electric log No  
 (yes or no)  
N/A  
 (organization running log)

(8) how well bottom plugged BWW

description of formations encountered	from	to
Clay	0	18
sd	18	46
Clay	46	95
sd	95	116
Clay-silt	116	147
sd	147	168
Clay-silt	168	350
sd	350	394
Clay-silt	394	585
sd	585	630

DRILLERS REMARKS: N/A


DEPT. OF NATURAL RESOURCES  
 BUREAU OF LAND & WATER RESOURCES

JUN 15 1984

**RECEIVED**

If well telescopes please sketch and show depths.

GROUND LEVEL

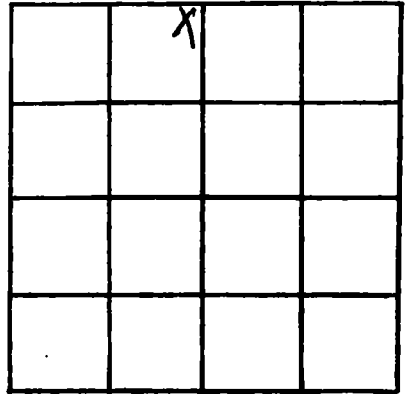

SECTION X

Please indicate well location X.

ADDITIONAL INFORMATION

If more than one screen,  
show locations of each on sketch.