

MISSISSIPPI DEPARTMENT OF NATURAL RESOURCES

Bureau of Land and Water Resources

Southport Mall

P.O. Box 10631

CODED

Jackson, Mississippi 39209

WATER WELL DRILLERS LOG

Hancock
K425

10-6-1984 date well completed Ward Well Dlg. firm name Hancock county well located

LANDOWNER: Austin's Winger

description of formations encountered

from to

67 Good St.

Fill - clay

0 12

Bay St. Louis, ms.
(mailing address)

Clay - silt

12 28

WELL LOCATION:

sec. 37 T. 8 N. R. 14 E. 14
3 miles N of A.S.L.
(distance) (direction) (nearest town)

fine sd

28 265

Clay - silt

265 290

Coarse sd

290 494

494 526

WELL PURPOSE: drinking
(home, irrigation, municipal, industrial)

WELL COMPLETION DATA:

(1) diameter (inches) 2"
(2) total depth (feet) 526
(3) static water level (feet) 6 below above top of ground.

(4) casing PVC, 506,
(material) (depth)
- If telescope see back.
(size)

(5) screen 20', -
(length) (depth to top)
2", PVC
(size) (material)

(6) pump owner, -
(HP) (yield gpm)
-
(type power)

(7) electric log NO
(yes or no)
N/A
(organization running log)

(8) how well bottom plugged BWV


DRILLERS REMARKS: natural flow

SP17-15-PSI 3

1-7-85
AW

If well telescopes please sketch and show depths.

GROUND LEVEL

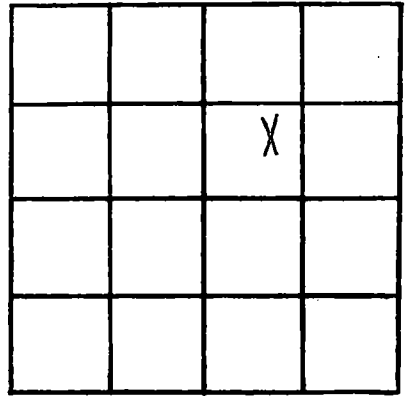

SECTION 37

Please indicate well location X.

ADDITIONAL INFORMATION

Lined area for additional information.

If more than one screen, show locations of each on sketch.