

MISSISSIPPI DEPARTMENT OF NATURAL RESOURCES

Bureau of Land and Water Resources

Southport Mall

P.O. Box 10631

Jackson, Mississippi 39209

WATER WELL DRILLERS LOG

HANCOCK
K 430
3/15/85

3/15/85

Mar 15 19 85 Ward Well Drg. Hancock
date well completed firm name county well located

LANDOWNER: Mark Whittington
Lakeshore Rd.
Lakeshore, Miss.
(mailing address)

description of formations encountered	from	to
fill - clay	0	18
sd	18	47
clay	47	98
sd - Red Marl	98	132
clay - silt	132	256
sd	256	280

WELL LOCATION:
sec. 18 T 9 N R 14 E
4 miles S/E of Lakeshore
(distance) (direction) (nearest town)

WELL PURPOSE: Home
(home, irrigation, municipal, industrial)

WELL COMPLETION DATA:

(1) diameter (inches) 2"

(2) total depth (feet) 280

(3) static water level (feet) 8 ^{below} top of ground

(4) casing PVC, 270, (material) (depth)
If telescope see back.

(5) screen 10' (length) (depth to top)
2" PVC (size) (material)

(6) pump owner (HP) (yield gpm)
(type power)

(7) electric log no (yes or no)
N/A (organization running log)

(8) how well bottom plugged B/W


DRILLERS REMARKS: N/A

RECEIVED
MAY 14 1985

Department of Natural Resources
Bureau of Land & Water Resources

If well telescopes please sketch and show depths.

GROUND LEVEL

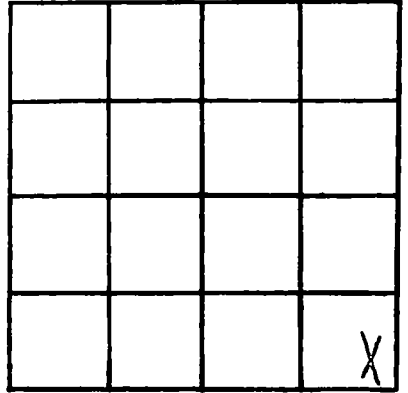

SECTION 18

Please indicate well location X.

ADDITIONAL INFORMATION

If more than one screen, show locations of each on sketch.