

MISSISSIPPI DEPARTMENT OF NATURAL RESOURCES

Bureau of Land and Water Resources

Southport Mall

P.O. Box 10631

Jackson, Mississippi 39209

WATER WELL DRILLERS LOG

CODED

Hancock
K432
4/12/85

4-12

1985

Mc Hill Well Works

Hancock

date well completed

firm name

county well located

LANDOWNER: Carmel Jeanfreed

description of formations encountered

from

to

Rt. 2 Box 383

Bay St. Louis Mo.
(mailing address)

Mud/Sand	0	20
Sand/Mud	20	40
Mud	40	80
Mud/Sand	80	100
Sand/Gravel	100	120
Mud	120	180
Mud/Sand	180	200
Sand	200	240

WELL LOCATION:

sec. 30 T. 8 N. R. 13 E.
2 miles S of Bay St. Louis
(distance) (direction) (nearest town)

WELL PURPOSE:

(home, irrigation, municipal, industrial)

WELL COMPLETION DATA:

- (1) diameter (inches) 2"
- (2) total depth (feet) 240'
- (3) static water level (feet) 40' below top of ground.
- (4) casing Ac. Sch. 40, 230'
(material) (depth)

 If telescope see back.
(size)

- (5) screen 10', 230'
(length) (depth to top)
- 2", Sch. 80 6 slot
(size) (material)

- (6) pump NONE
(HP) (yield gpm)

(type power)

- (7) electric log
(yes or no)

(organization running log)

- (8) how well bottom plugged Sand
Shark

DRILLERS REMARKS:


RECEIVED

JUN 4 1985

Department of Natural Resources
Bureau of Land & Water Resources

If well telescopes please sketch and show depths.

GROUND LEVEL

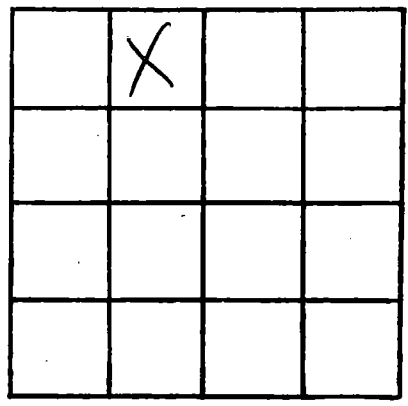

SECTION _____

Please indicate well location X.

ADDITIONAL INFORMATION

Lined area for additional information.

If more than one screen, show locations of each on sketch.