

Hancock
K 434
5-27-85

MISSISSIPPI DEPARTMENT OF NATURAL RESOURCES
Bureau of Land and Water Resources
Southport Mall
P.O. Box 10631
Jackson, Mississippi 39209
WATER WELL DRILLERS LOG

CODED

L

5-27 1985 Ward Well Drg. Hancock
date well completed firm name county well located

LANDOWNER: Ralph Fisher
John Bayan Rd.
Bay St. Louis, ms.
(mailing address)

description of formations encountered	from	to
fill - clay	0	20
ss - pea gravel	20	112
pea gravel - gravel	112	168
clay - silt	168	275
fine sd	275	298
clay - silt	298	405
fine sd	405	420
clay - silt	420	510
coarse sd	510	547

WELL LOCATION:
sec. 42 T 8 N R 13 E
4 miles N/W of B.S.L.
(distance) (direction) (nearest town)

WELL PURPOSE: Home
(home, irrigation, municipal, industrial)

WELL COMPLETION DATA:

(1) diameter (inches) 2"

(2) total depth (feet) 546

(3) static water level (feet) 8 below top of ground. above

(4) casing PVC, 526,
(material) (depth)
- if telescope see back.
(size)

(5) screen 20', -
(length) (depth to top)
2", PVC
(size) (material)

(6) pump -, -
(HP) (yield gpm)
-
(type power)

(7) electric log NO
(yes or no)
N/A
(organization running log)

(8) how well bottom plugged BWU

RECEIVED


JUL 2 1985

DRILLERS REMARKS: flowed approx
12 GPM - 2 PSI.

Department of Natural Resources
Bureau of Land & Water Resources

If well telescopes please sketch and show depths.

GROUND LEVEL

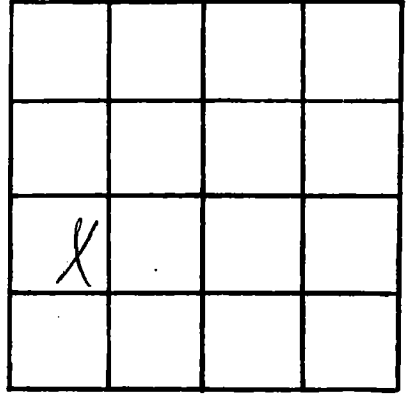

SECTION 42

Please indicate well location X.

ADDITIONAL INFORMATION

If more than one screen,
show locations of each on sketch.