

MISSISSIPPI DEPARTMENT OF NATURAL RESOURCES

Bureau of Land and Water Resources

Southport Mall

P.O. Box 10631

Jackson, Mississippi 39209

WATER WELL DRILLERS LOG

CODED

HANCOCK  
15436  
8/14/85

8-14-85 date well completed

POUNCEY WATER WELL DRILLING

firm name

Hancock county well located

LANDOWNER: Brack Sealy

5ky Lane Drive

Hardy Dale  
(mailing address)

description of formations encountered

from to

fill dirt 0 14

sd & gravel 14 68

Clay some 68 520

sd fine to fair 520 560

WELL LOCATION:

sec. 27 T 2 N R. 14 E  
on Bay miles (distance) of Bay (direction) of Bay (nearest town)

WELL PURPOSE: camp  
(home, irrigation, municipal, industrial)

WELL COMPLETION DATA:

(1) diameter (inches) 2

(2) total depth (feet) 560

(3) static water level (feet) 14 below top of ground

(4) casing PVC 545  
(material) (depth)

2 (size) If telescope see back.

(5) screen 15 545  
(length) (depth to top)

2 (size) PVC (material)

(6) pump Flowline  
(HP) (yield gpm)

12 gpm (type power)

(7) electric log (yes or no)

(organization running log)

(8) how well bottom plugged Sealed.

CODED


RECEIVED  
SEP 8 - 1985

DRILLERS REMARKS:

Department of Natural Resources  
Bureau of Land & Water Resources

If well telescopes please sketch and show depths.

GROUND LEVEL

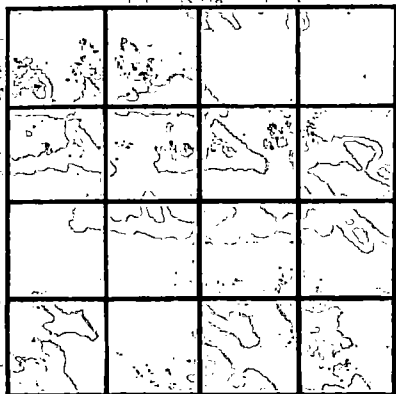

SECTION \_\_\_\_\_

Please indicate well location X.

**ADDITIONAL INFORMATION**

If more than one screen, show locations of each on sketch.