

MISSISSIPPI DEPARTMENT OF NATURAL RESOURCES

Bureau of Land and Water Resources

Southport Mall

P.O. Box 10631

Jackson, Mississippi 39209

WATER WELL DRILLERS LOG

CODED

Hancock
K437
9-13-85

Sept. 13 1985 date well completed
85 Ward Well Drg. firm name
Hancock county well located

LANDOWNER: John P. Bollen
North Beach
Bay St. Louis, ms.
(mailing address)

description of formations encountered

from to

Fill

0 3

Clay

3 21

sd
St - Red Gravel

21 94

Clay - sd

94 138

Core sd

138 336

336 370

WELL LOCATION:

sec. 37 T. 8 N R. 13 E
4 miles N of B.S.L.
(distance) (direction) (nearest town)

WELL PURPOSE: Home
(home, irrigation, municipal, industrial)

WELL COMPLETION DATA:

- (1) diameter (inches) 4" X 2"
- (2) total depth (feet) 370
- (3) static water level (feet) 4 below top of ground.
- (4) casing PVC 350 (material) (depth)
- (size) if telescope see back.
- (5) screen 20' (length) (depth to top)
- 2" PVC (size) (material)
- (6) pump owner (HP) (yield gpm)
- (type power)
- (7) electric log NO (yes or no)
- N/A (organization running log)
- (8) how well bottom plugged BWU


RECEIVED

NOV 20 1985

DRILLERS REMARKS: well for Home & Heat Pump. Showed approx. 15 G.P.M. @ 3 P.S.I.

Department of Natural Resources
Bureau of Land & Water Resources

If well telescopes please sketch and show depths.

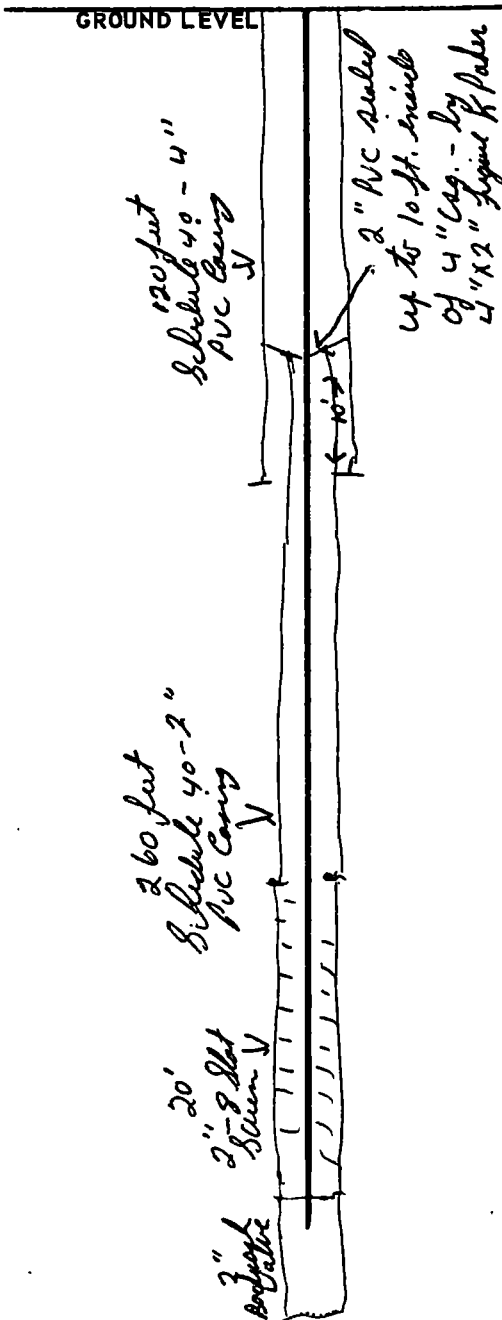

	X		

SECTION 37

Please indicate well location X.

ADDITIONAL INFORMATION

If more than one screen, show locations of each on sketch.