

MISSISSIPPI DEPARTMENT OF NATURAL RESOURCES

Bureau of Land and Water Resources

Southport Mall

P.O. Box 10631

Jackson, Mississippi 39209

WATER WELL DRILLERS LOG

HANCOCK  
K 439  
30-16-58  
89-26-24

CODED

Nov. 18 1985 Ward Well Dr. Hancock  
 date well completed firm name county well located

LANDOWNER: <u>Bay Side Park Baptist Church</u>	description of formations encountered	from	to
<u>Bay Side Park</u>			
<u>Bay St. Louis, ms.</u> (mailing address)	<u>clay</u>	<u>0</u>	<u>12</u>
	<u>sd</u>	<u>12</u>	<u>48</u>
	<u>clay</u>	<u>48</u>	<u>95</u>
	<u>sd</u>	<u>95</u>	<u>132</u>
	<u>clay - silt</u>	<u>132</u>	<u>147</u>
	<u>sd - Iron Shovel</u>	<u>147</u>	<u>166</u>

WELL LOCATION:  
 sec. 6 T. 9 N. R. 14 E.  
8 miles W of Waverly  
 (distance) (direction) (nearest town)

WELL PURPOSE: Home Church  
 (home, irrigation, municipal, industrial)

- WELL COMPLETION DATA:
- (1) diameter (inches) 2"
  - (2) total depth (feet) 168
  - (3) static water level (feet) 12 <sup>Galby</sup> above top of ground.
  - (4) casing PVC 158  
 (material) (depth)  
- If telescope see back.  
 (size)
  - (5) screen 10' -  
 (length) (depth to top)  
2" PVC  
 (size) (material)
  - (6) pump Owner -  
 (HP) (yield gpm)  
-  
 (type power)
  - (7) electric log NO  
 (yes or no)  
N/A  
 (organization running log)
  - (8) how well bottom plugged BWN


DRILLERS REMARKS: N/A

**RECEIVED**  
 DEC 16 1985

Department of Natural Resources  
 Bureau of Land & Water Resources

If well telescopes please sketch and show depths.

GROUND LEVEL

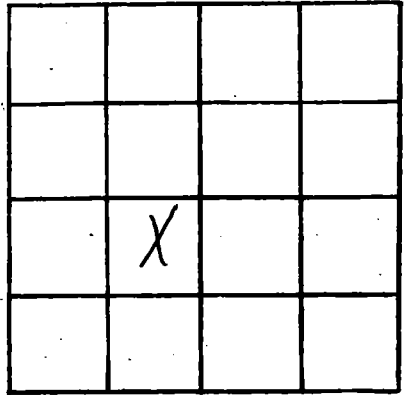

SECTION 6

Please indicate well location X.

ADDITIONAL INFORMATION

If more than one screen, show locations of each on sketch.