

MISSISSIPPI DEPARTMENT OF NATURAL RESOURCES

Bureau of Land and Water Resources

Southport Mall

P.O. Box 10631

Jackson, Mississippi 39209

WATER WELL DRILLERS LOG

CODED

Hancock
R 440
 30-20-08
 89-21-53

Jan. 18 19 86 Wood Well Dr. Hancock
 date well completed firm name county well located

LANDOWNER: Jack Hively
96 Fiber St.
Bay St. Louis, Mo.
 (mailing address)

description of formations encountered	from	to
<u>Clay</u>	<u>0</u>	<u>21</u>
<u>sd</u>	<u>21</u>	<u>38</u>
<u>Clay-silt</u>	<u>38</u>	<u>96</u>
<u>sd w/ clay streaks</u>	<u>96</u>	<u>142</u>
<u>Clay-silt</u>	<u>142</u>	<u>244</u>
<u>Fine sd</u>	<u>244</u>	<u>276</u>
<u>Clay-silt</u>	<u>276</u>	<u>390</u>
<u>Fine sd</u>	<u>390</u>	<u>425</u>
<u>Clay-silt</u>	<u>425</u>	<u>484</u>
<u>Coarse sd - Red Sand</u>	<u>484</u>	<u>526</u>

WELL LOCATION:
 12/12 sec. 37 T. 8 N R. 14 E
5 miles N/W of B.S.L.
 (distance) (direction) (nearest town)

WELL PURPOSE: Home
 (home, irrigation, municipal, industrial)

WELL COMPLETION DATA:

(1) diameter (inches) 2"

(2) total depth (feet) 526

(3) static water level (feet) 5 below top of ground.

(4) casing PVC, 506,
 (material) (depth)
- If telescope see back.
 (size)

(5) screen 20', -
 (length) (depth to top)
2", PVC
 (size) (material)

(6) pump owner, -
 (HP) (yield gpm)
-
 (type power)

(7) electric log NO
 (yes or no)
N/A
 (organization running log)

(8) how well bottom plugged BWV

CODED


RECEIVED
 MAR 6 - 1986

DRILLERS REMARKS: Well flows
approx. 15 GPM. - 3 PSI

Department of Natural Resources
 Bureau of Land & Water Resources

If well telescopes please sketch and show depths.

GROUND LEVEL

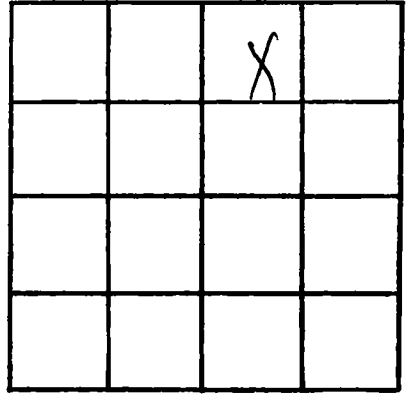

SECTION 37

Please indicate well location X.

ADDITIONAL INFORMATION

If more than one screen,
show locations of each on sketch.