

MISSISSIPPI DEPARTMENT OF NATURAL RESOURCES

Bureau of Land and Water Resources

Southport Mall

P.O. Box 10631

Jackson, Mississippi 39209

WATER WELL DRILLERS LOG

CODED

Hancock  
R 441

Jan. 14 1986 Ward Well Drg. Hancock  
date well completed firm name county well located

LANDOWNER Artigue Construct.  
Harry 90 West  
Bay St. Louis, Ms.  
(mailing address)

WELL LOCATION:  
sec. 37 T. 8 N R. 14 E  
5 miles N/W of B.S.L.  
(distance) (direction) (nearest town)

WELL PURPOSE: None  
(home, irrigation, municipal, industrial)

WELL COMPLETION DATA:

(1) diameter (inches) 2"

(2) total depth (feet) 526

(3) static water level (feet) 6 below top of ground.

(4) casing PVC, 506,  
(material) (depth)  
- if telescope see back.  
(size)

(5) screen 20', -  
(length) (depth to top)  
2", PVC  
(size) (material)


(6) pump owner, -  
(HP) (yield gpm)  
e  
(type power)

(7) electric log NO  
(yes or no)  
N/A  
(organization running log)

(8) how well bottom plugged BWU

description of formations encountered	from	to
clay	0	21
sd	21	47
clay	47	76
Red sand - sd	76	88
clay	88	95
sd with grey mud	95	141
clay & silt	141	395
fine sd	395	420
clay - silt	420	485
Coarse sd - Red sand	485	526


CODED

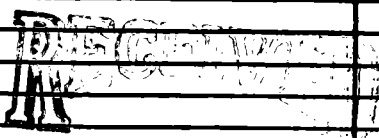

DRILLERS REMARKS: well flowed  
approx. 18 GPM - 3 PSI

If well telescopes please sketch and show depths.

GROUND LEVEL

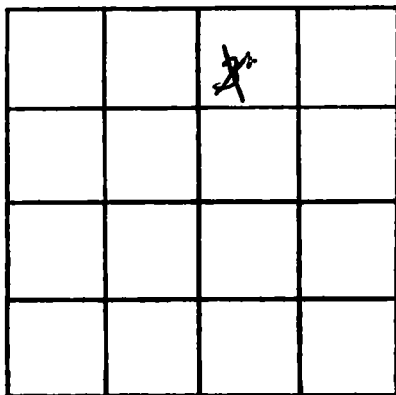

SECTION 37

Please indicate well location X.

ADDITIONAL INFORMATION

If more than one screen, show locations of each on sketch.