

HANCOCK
K 442

MISSISSIPPI DEPARTMENT OF NATURAL RESOURCES
Bureau of Land and Water Resources
Southport Mall
P.O. Box 10631
Jackson, Mississippi 39209
WATER WELL DRILLERS LOG

CODED

May 13 1986 Ward Well Drg Hancock
date well completed firm name county well located

LANDOWNER: Thorne Sanbut
Chapman Rd - Box 214
Bay St. Louis ms,
(mailing address)

description of formations encountered	from	to
Clay	0	18
Clay ^{sd}	18	46
Clay	46	95
Fine ^{sd}	95	115
Clay - Silt	115	150
Fine ^{sd}	150	174
Clay - Silt	174	265
Fine ^{sd}	265	296
Clay - Silt	296	374
Coar ^{sd}	374	416

WELL LOCATION:
sec. 22 T. 9^N R. 14^E
5 miles N/W of Bay St. Louis
(distance) (direction) (nearest town)

WELL PURPOSE: Home
(home, irrigation, municipal, industrial)

- WELL COMPLETION DATA:
- (1) diameter (inches) 2"
 - (2) total depth (feet) 416
 - (3) static water level (feet) 1 ^{below} above top of ground.
 - (4) casing PVC, 396,
(material) (depth)
- If telescope see back.
(size)
 - (5) screen 20', -
(length) (depth to top)
2", PVC
(size) (material)
 - (6) pump owner -
(HP) (yield gpm)
-
(type power)
 - (7) electric log NO
(yes or no)
N/A
(organization running log)
 - (8) how well bottom plugged BWD

CODED


RECEIVED
JUN 27 1986

Department of Natural Resources
Bureau of Land & Water Resources

DRILLERS REMARKS: N/A

If well telescopes please sketch and show depths.

GROUND LEVEL

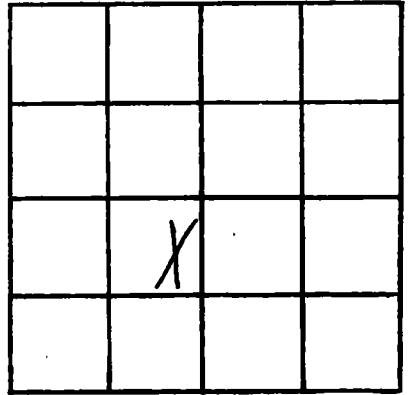

SECTION 22

Please indicate well location X.

ADDITIONAL INFORMATION

If more than one screen, show locations of each on sketch.